No. 579


Record of Survey.

Township Lake Waubawega Subd., North of Range ..... of 4 Principal Meridian as presented by the courses and distances on the following plat, and annexed field-notes of survey:

Established the center of the section at the point of intersection of STRAIGHT quarter lines.

Established all quarter-quarter corners upon the section boundary at proportional distances between known section and quarter section corners, according to the original field-notes of the Government survey.

Established all lost corners at proportionate distances between known corners, according to the original field notes of the Government survey.

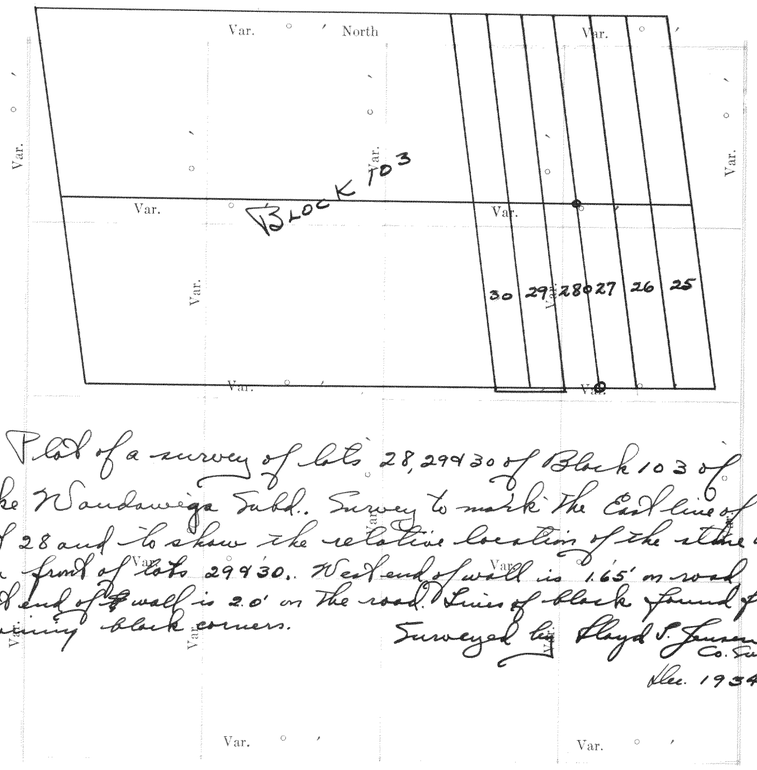

Plat of a survey of lots 28, 29 & 30 of Block 103 of Lake Waubawega Subd.. Survey to mark the East lines of lot 28 and to show the relative location of the stone wall in front of lots 29 & 30.. West end of wall is 1.65' on road. East end of wall is 2.0' on the road. Lines of block found from adjoining block corners.

Surveyed by Lloyd S. Jensen Co. Sur.
Dec. 1934

Plat of Section ....., Township ..... North, Range ..... of 4 Principal Meridian Scale 80 chains to 6 inches. The figures in red ink are the lengths of the lines as stated in the field-notes of the Government survey.

Declination of the Magnetic Meridian from the True Meridian .....

Surveyed and sub-divided ..... A. D. 1 , in accordance with the State Laws and Instructions of the Commissioner of the General Land office, and recorded on pages ..... of Register in the County Clerk's office.

Witness my hand this ..... day of ..... A. D. 1

..... SURVEYOR.

DESCRIPTION


OF SECTION, QUARTER SECTION AND QUARTER QUARTER SECTION CORNERS

193

N. C. MILLER CO. MFG. STATIONERS, MILWAUKEE X15000

GOVERNMENT CORNERS	Bearing Trees	In. Dia.	Courses they bear	Links Distant	Bearing Trees	In. Dia.	Courses they bear	Links Distant	Bearing Trees	In. Dia.	Courses they bear	Links Distant	Bearing Trees	In. Dia.	Courses they bear	Links Distant
No.																
1. N. W. Sec. Cor. indentified,																
2. N. E. Sec. Cor. indentified,																
3. S. E. Sec. Cor. indentified,																
4. S. W. Sec. Cor. indentified,																
5. N. ¼ Sec. Cor. indentified,																
6. E. ¼ Sec. Cor. indentified,																
7. S. ¼ Sec. Cor. indentified,																
8. W. ¼ Sec. Cor. indentified,																
Subdivision Corners																
No.																
1. Center ¼ Sec. Cor.																
2. North ¼-¼s N. W. qr.,																
3. East ¼-¼s N. W. qr.,																
4. South ¼-¼s N. W. qr.,																
5. West ¼-¼s N. W. qr.,																
6. Center ¼-¼s N. W. qr.,																
7. North ¼-¼s N. E. qr.,																
8. East ¼-¼s N. E. qr.,																
9. South ¼-¼s N. E. qr.,																
10. Center ¼-¼s N. E. qr.,																
11. East ¼-¼s S. E. qr.,																
12. South ¼-¼s S. E. qr.,																
13. West ¼-¼s S. E. qr.,																
14. Center ¼-¼s S. E. qr.,																
15. South ¼-¼s S. W. qr.,																
16. West ¼-¼s S. W. qr.,																
17. Center ¼-¼s S. W. qr.																

No. 580

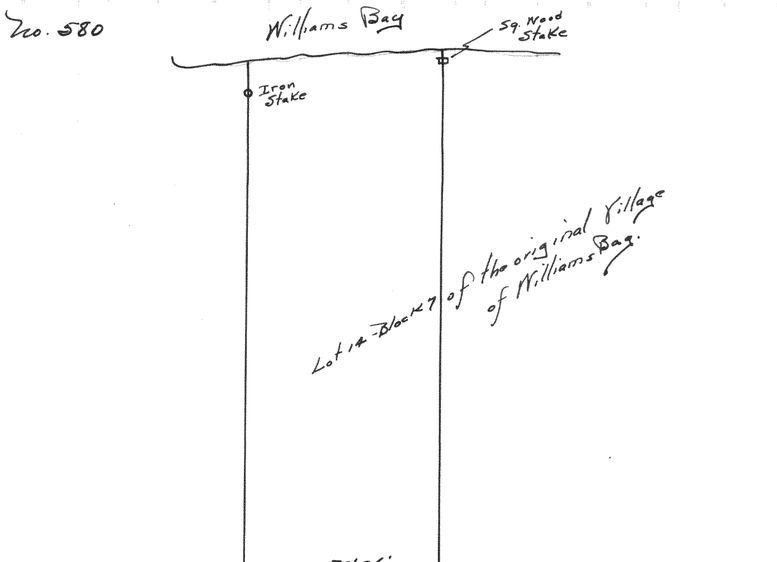


Used South line of Section lot and the NW. cor. of Block 7, total dist. = 1047.84', Platted dist. = 1046.68
Overrun for this parcel = .06'.
The NW. cor. of Lot 14 falls 0.15' N. of the N. face of the N. sq. wood post at the West end of the School Lot.

Surveyed by Lloyd S. Jensen
Co. Sur.
Dec. 1934

NAMES OF SWORN ASSISTANTS

CHAINMEN	FLAGMEN	AXMEN


No. 581 Lot 9, Block 1 of Williams Bay

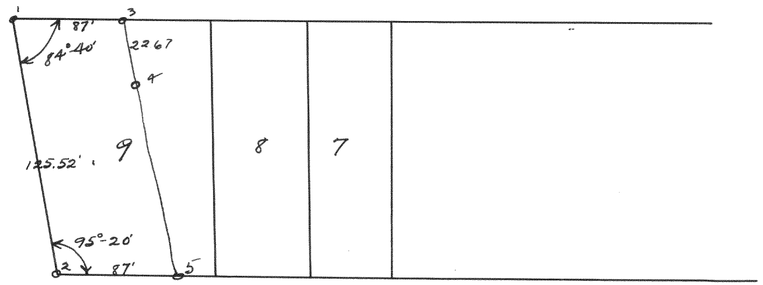

Plat of a survey of the South 87 feet of lot 9 of block 1 of the original village of Williams Bay.
Found iron pin at 1.
Placed "pipes" 2, 3, 4 & 5.

Surveyed by Lloyd S. Jensen
Co. Sur.
Dec. 1934

No. 582 Lot 7 & part of Lot 8, Block 21
Frey's Addition, Darien

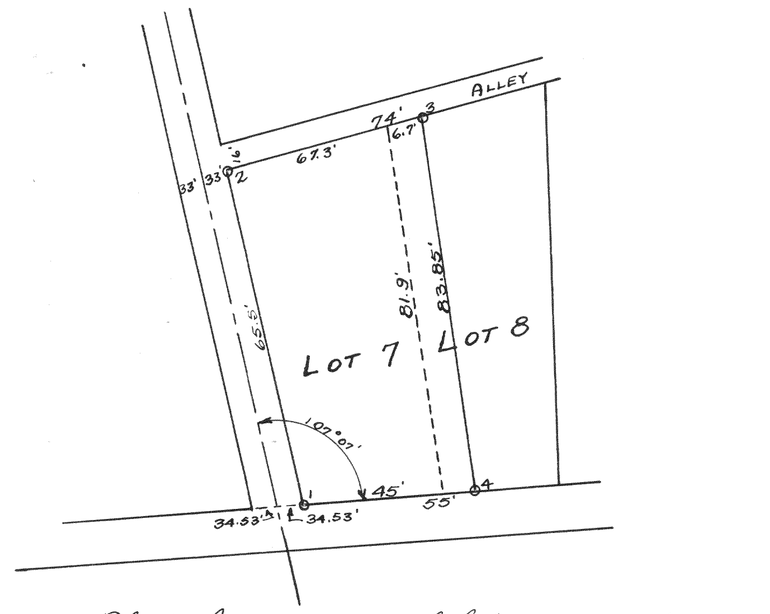

Plat of a survey of lot 7 and part of lot 8 of block 21 of Frey's Addition to the village of Darien.
Placed iron pipes at 2, 3, 4 4
Cross cut in concrete at 1.

Lloyd S. Jensen
Co. Sur.