No. 590
BLOCK 19, ORIGINAL TOWN, EAST TROY


Record of Survey.

Township ..... North of Range ..... of 4 Principal Meridian as presented by the courses and distances on the following plat, and annexed field-notes of survey:


Established the center of the section at the point of intersection of STRAIGHT quarter lines.

Established all quarter-quarter corners upon the section boundary at proportional distances between known section and quarter section corners, according to the original field-notes of the Government survey.

Established all lost corners at proportionate distances between known corners, according to the original field notes of the Government survey.

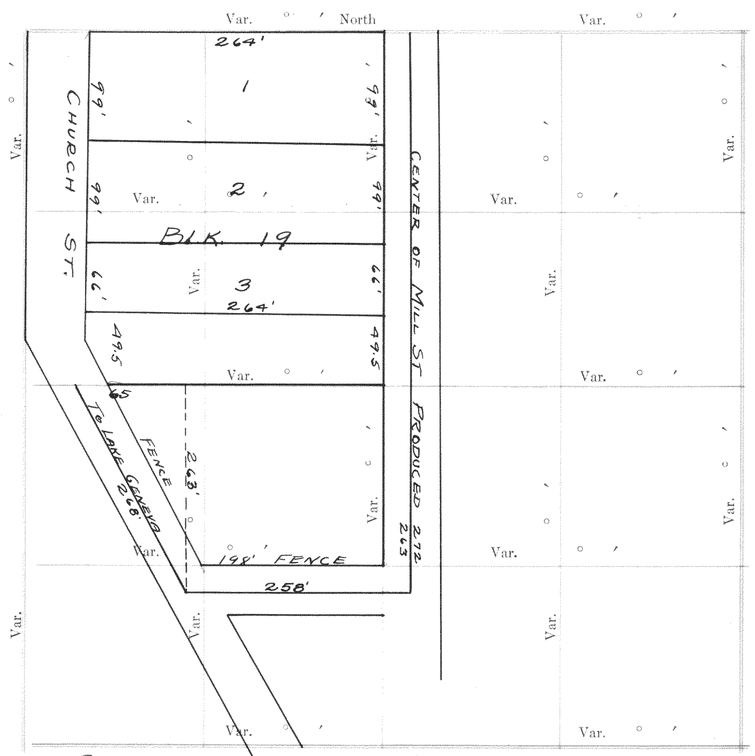
Var. ° ' North
Var. ° '
264'
1
2
3
BLK. 19
CHURCH ST.
CENTER OF MILL ST PRODUCED
99'
99'
99'
99'
264'
264'
495'
495'
Var.
Var. ° '
Var.
Var.
Var.

No. 592. Block 118, Lake Wandawega Sub.
In Sec. 1, T3N, R 16E

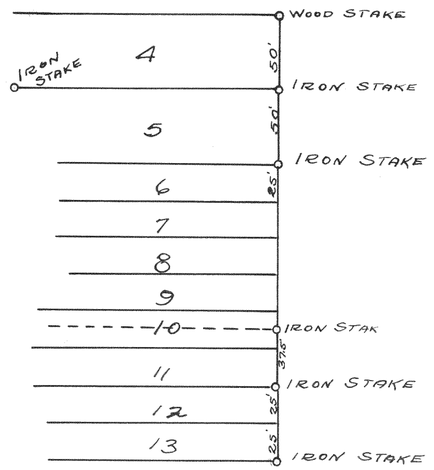


Plat of a survey of lot 5 in block 118 of Wandawega Subdivision.

Feb. 2, 1935

Floyd S. Jensen
Co. Sur.

No. 593 Part of Lots 4, 5, 6 of Block 8
Original Town of Darien.

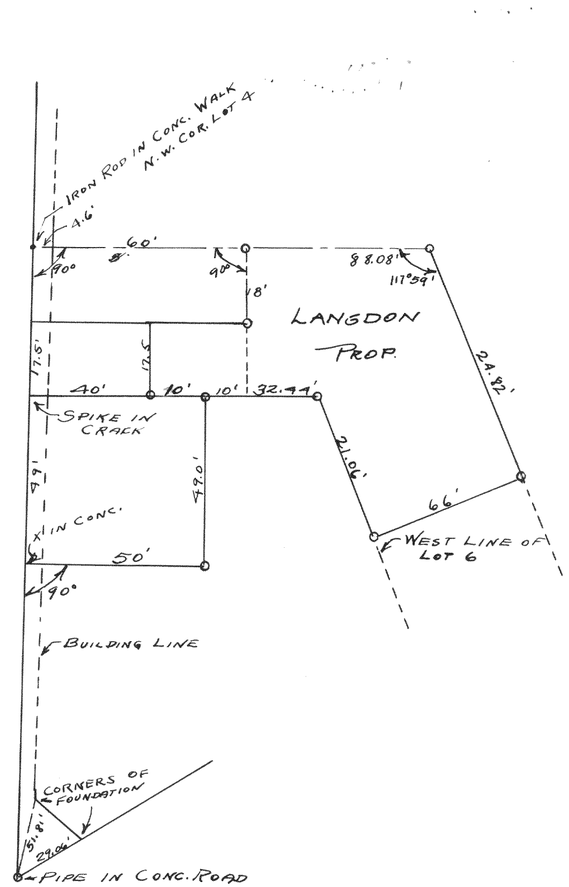

Plat of a survey of Langdon Property in Block 8 of Original Town of Darien

Jan. 11, 1934

Floyd S. Jensen
Co. Sur.