Record of Survey.


No. 602- SURVEY OF LAND IN NW¼ SEC. 10 AND NE¼ SEC. 9, T 4 N R 18 E

Township....., North of Range.....of 4 Principal Meridian as presented by the courses and distances on the following plat, and annexed field-notes of survey:

Established the center of the section at the point of intersection of STRAIGHT quarter lines.

Established all quarter-quarter corners upon the section boundary at proportional distances between known section and quarter section corners, according to the original field-notes of the Government survey.

Established all lost corners at proportionate distances between known corners, according to the original field notes of the Government survey.

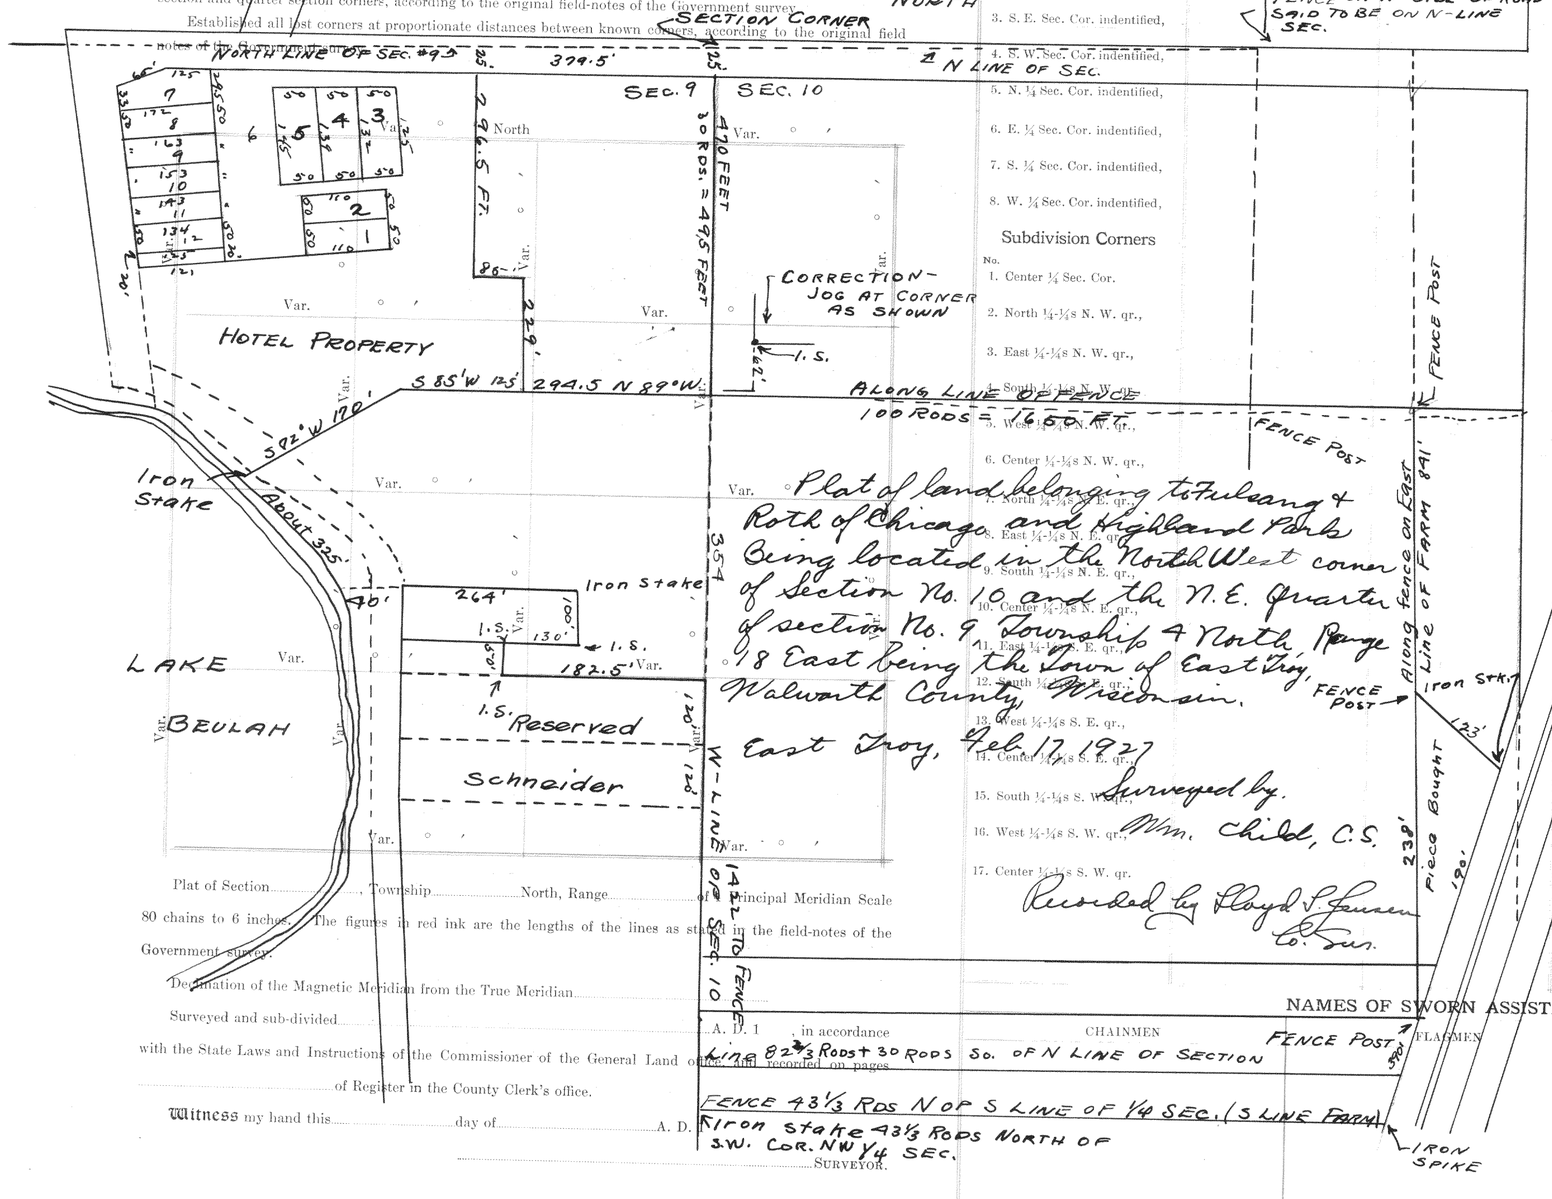

Plat of Section....., Township.....North, Range.....of Principal Meridian Scale 80 chains to 6 inches. The figures in red ink are the lengths of the lines as stated in the field-notes of the Government survey.

Declination of the Magnetic Meridian from the True Meridian.....

Surveyed and sub-divided.....A. D. 1 , in accordance with the State Laws and Instructions of the Commissioner of the General Land office and recorded on pages.....of Register in the County Clerk's office.

Witness my hand this.....day of.....A. D.

.....SURVEYOR.

DESCRIPTION

OF SECTION, QUARTER SECTION AND QUARTER QUARTER SECTION CORNERS

H. C. MILLER CO., MFG. STATIONERS, MILWAUKEE X15000

GOVERNMENT CORNERS	Bearing Trees	In. Dia.	Courses they bear	Links Distant	Bearing Trees	In. Dia.	Courses they bear	Links Distant
No.								
1. N. W. Sec. Cor. indentified,								
2. N. E. Sec. Cor. indentified,								
3. S. E. Sec. Cor. indentified,								
4. S. W. Sec. Cor. indentified,								
5. N. ¼ Sec. Cor. indentified,								
6. E. ¼ Sec. Cor. indentified,								
7. S. ¼ Sec. Cor. indentified,								
8. W. ¼ Sec. Cor. indentified,								
Subdivision Corners								
No.								
1. Center ¼ Sec. Cor.								
2. North ¼-¼'s N. W. qr.,								
3. East ¼-¼'s N. W. qr.,								
4. South ¼-¼'s N. W. qr.,								
5. West ¼-¼'s N. W. qr.,								
6. Center ¼-¼'s N. W. qr.,								
7. North ¼-¼'s N. E. qr.,								
8. East ¼-¼'s N. E. qr.,								
9. South ¼-¼'s N. E. qr.,								
10. Center ¼-¼'s N. E. qr.,								
11. East ¼-¼'s S. E. qr.,								
12. South ¼-¼'s S. E. qr.,								
13. West ¼-¼'s S. E. qr.,								
14. Center ¼-¼'s S. E. qr.,								
15. South ¼-¼'s S. W. qr.,								
16. West ¼-¼'s S. W. qr.,								
17. Center ¼-¼'s S. W. qr.								


NAMES OF SWORN ASSISTANTS

CHAINMEN

FLAGMEN

AXMEN

No. 603 Survey In SW¼ of NE¼ of Sec. 18 And SE¼ of NW¼ of Sec. 18, T4N, R18E

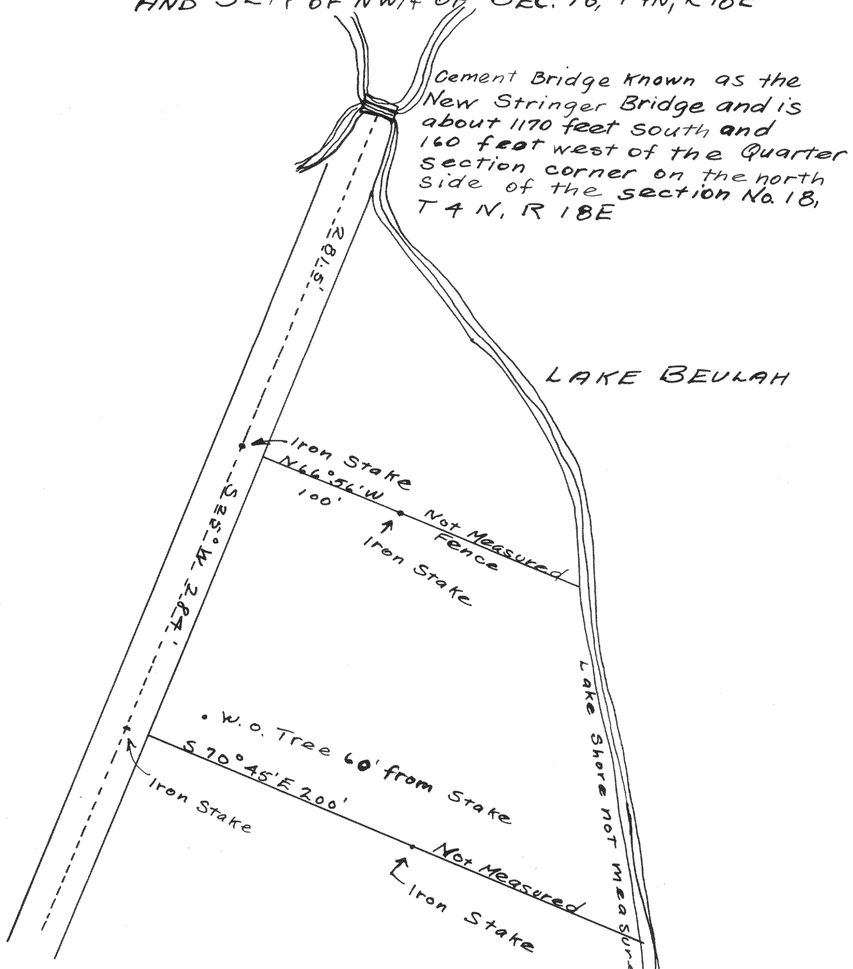


Plat of a survey made for Wm. Hutkon the South East quarter of the Northwest quarter and the Southwest quarter of the North east quarter of Section No. 18, Town No. 4 North, Range No. 18 East being the Township of East Troy, Walworth County, Wisconsin

East Troy, Oct. 16, 1923 Wm. Child, C. S.

Recorded by Floyd S. Jensen Co. Sur.

No. 604 - Farm Survey in Sec. 17 & 20, T 4 N, R 18 E.

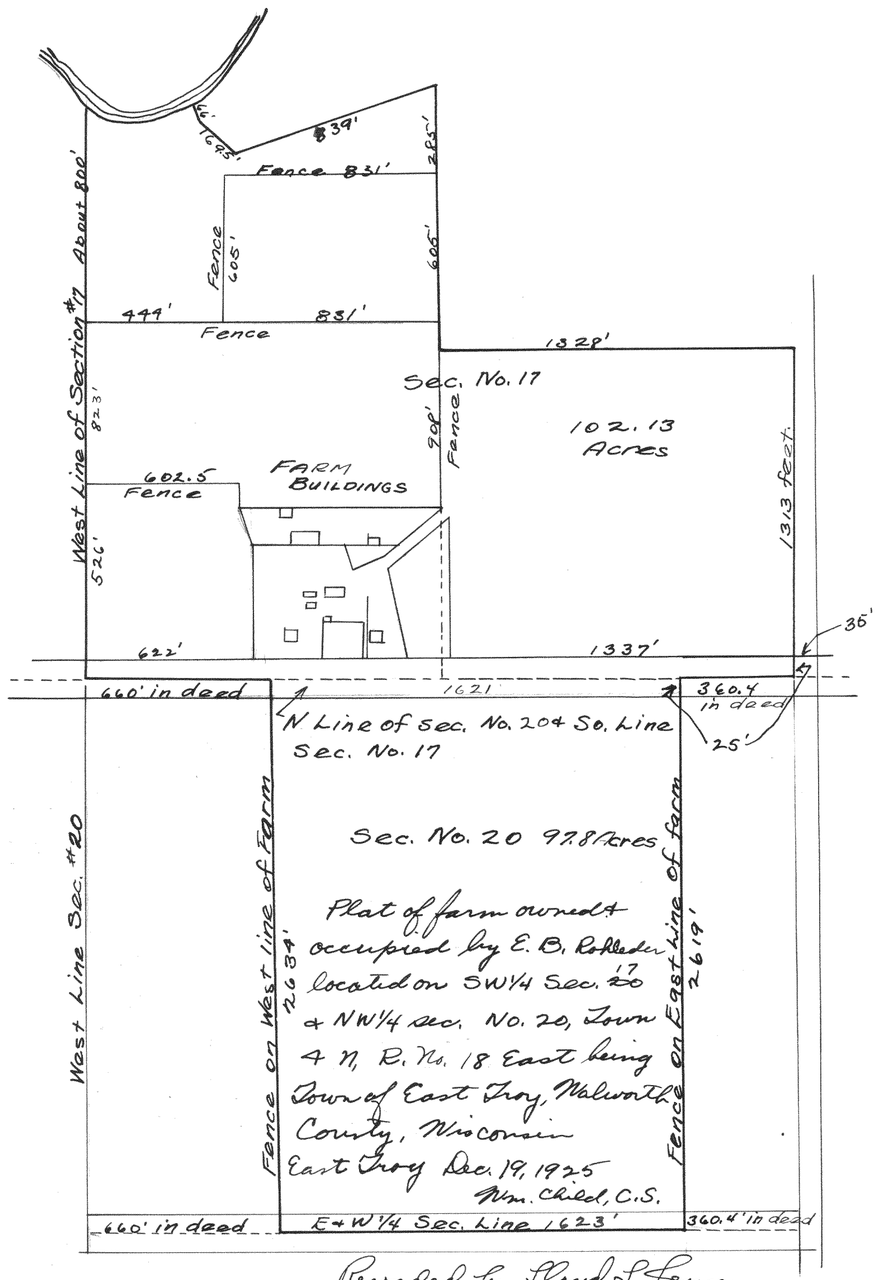

Recorded by Floyd S. Jensen Co. Sur.