

No. 44

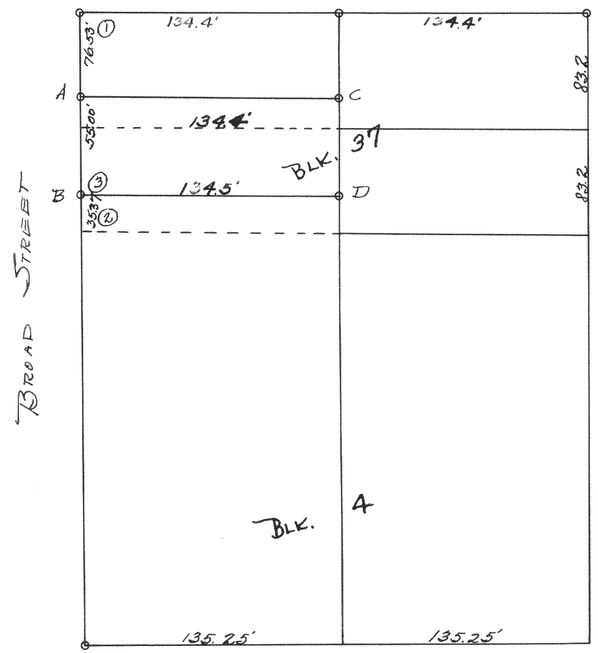

Survey of a 55 foot lot in Block 37 of Davis Add.
Location - Sec. 36, T31 N, R16E.

Used figures from the plat book of the City of Elkhorn as compiled by City Engineer Mr. Fabbs.
Sighted on S.W. cor. of Block 4 of original town turned angle of 90°-04' and sighted iron pin at NE. cor. of Blk. 34.
Angle ② = 89°-55'
Angle ③ = 89°-55'
Set iron pipes at A, B, C & D.
Set owned by Mr Peter Lowes, Elkhorn, Wisconsin
FEB 19, 1933 Survey Floyd S. Jensen
Recorded March 18, 1933. County Surveyor

No. 45

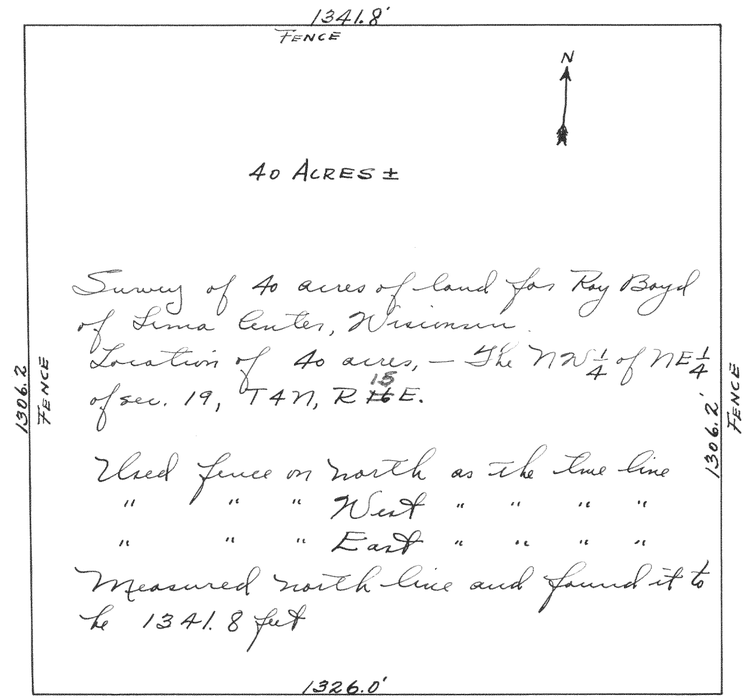

Survey of 40 acres of land for Ray Boyd of Lima Center, Wisconsin.
Location of 40 acres, — The NW¼ of NE¼ of sec. 19, T4N, R15E.

Used fence on north as the true line
" " " West " " " "
" " " East " " " "
Measured north line and found it to be 1341.8 feet

Measured south line at 80 rods from north fence and found it to be 1326.0 feet in length.

1341.8
1326.0
2 | 2667.8
1333.9

43560 x 40 ÷ 1333.9 = 1306.2 = the length of the East & West lines of the 40 acres.

Both buyer Mr. Henry Budka and seller Mr. Ray Boyd were present and were satisfied with the above method. March 3, 1933

Floyd S. Jensen
County Surveyor.