Record of Survey.


No. 609 LOT 10, LONG POINT SUB.

Township ..... , North of Range ..... of 4 Principal Meridian as presented by the courses and distances on the following plat, and annexed field-notes of survey:

Established the center of the section at the point of intersection of STRAIGHT quarter lines.

Established all quarter-quarter corners upon the section boundary at proportional distances between known section and quarter section corners, according to the original field-notes of the Government survey.

Established all lost corners at proportionate distances between known corners, according to the original field notes of the Government survey.

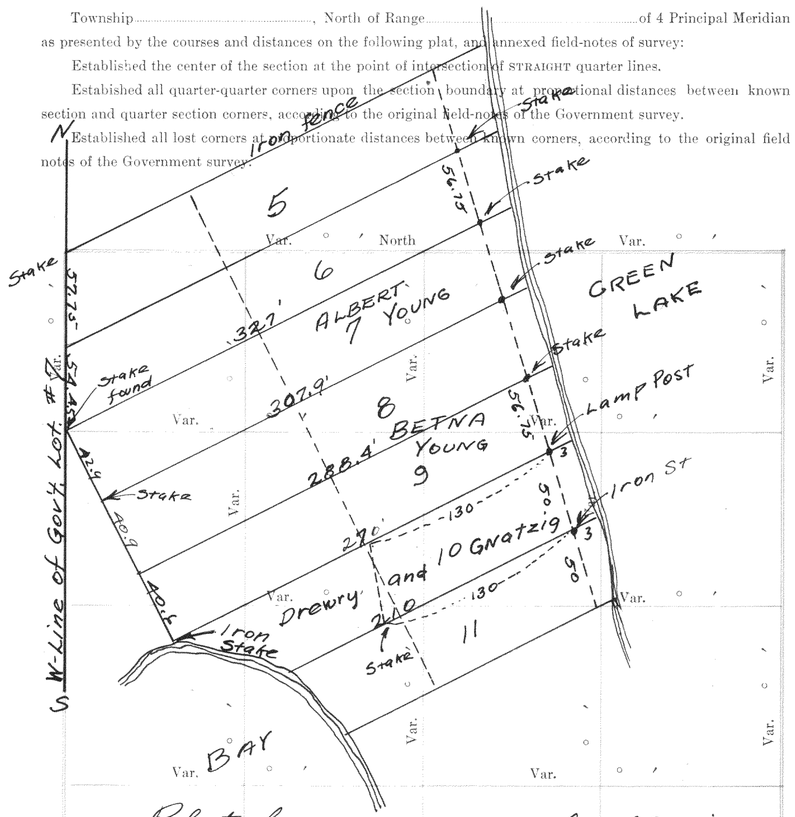

Plat of a survey made by the direction of Drewry and Gratzig of Whitewater Wis. to relocate the lines and corners of Lot No. 10 of the Plat of Long Point (Vol. 5 #66.) The said plat being located in the South east quarter of Section No. 26, Town No. 1 North Range No. 16 East being the Town of Lafayette, Walworth County Wis.

Plat of Section ..... Township ..... North, Range ..... of 4 Principal Meridian Scale 80 chains to 6 inches. The figures in red ink are the lengths of the lines as stated in the field-notes of the Government survey.

Declination of the Magnetic Meridian from the True Meridian .....

Surveyed and sub-divided ..... A. D. 1 ..... in accordance with the State Laws and Instructions of the Commissioner of the General Land Office, and recorded on page ..... of Registers in the County Clerk's office.

Milliest ..... Surveyor.

There is no distance given on the recorded plat for the south west end of the said lot to establish the North Westerly line of the lot and I begin to measure Southwardly 50 feet parallel with the Basis Line as shown on the plat.

Elkhorn, Oct. 1925

Wm. Child C.S.
Recorded by Floyd S. Jensen Co. Sur.


DESCRIPTION

OF SECTION, QUARTER SECTION AND QUARTER QUARTER SECTION CORNERS

H. C. MILLER-CO. MFG. STATIONERS, MILWAUKEE X15000

GOVERNMENT CORNERS	Bearing Trees	In. Dia.	Courses they bear	Links Distant	Bearing Trees	In. Dia.	Courses they bear	Links Distant	Bearing Trees	In. Dia.	Courses they bear	Links Distant	Bearing Trees	In. Dia.	Courses they bear	Links Distant
No.																
1. N. W. Sec. Cor. indentified,																
2. N. E. Sec. Cor. indentified,																
3. S. E. Sec. Cor. indentified,																
4. S. W. Sec. Cor. indentified,																
5. N. ¼ Sec. Cor. indentified,																
6. E. ¼ Sec. Cor. indentified,																
7. S. ¼ Sec. Cor. indentified,																
8. W. ¼ Sec. Cor. indentified,																
Subdivision Corners																
No.																
1. Center ¼ Sec. Cor.																
2. North ¼-⅛s N. W. qr.,																
3. East ¼-⅛s N. W. qr.,																
4. South ¼-⅛s N. W. qr.,																
5. West ¼-⅛s N. W. qr.,																
6. Center ¼-⅛s N. W. qr.,																
7. North ¼-⅛s N. E. qr.,																
8. East ¼-⅛s N. E. qr.,																
9. South ¼-⅛s N. E. qr.,																
10. Center ¼-⅛s N. E. qr.,																
11. East ¼-⅛s S. E. qr.,																
12. South ¼-⅛s S. E. qr.,																
13. West ¼-⅛s S. E. qr.,																
14. Center ¼-⅛s S. E. qr.,																
15. South ¼-⅛s S. W. qr.,																
16. West ¼-⅛s S. W. qr.,																
17. Center ¼-⅛s S. W. qr.																

NO. 610 BLOCK 7, PASSAGE ARAM DOWNIES ADD.
CITY OF DELAVAN

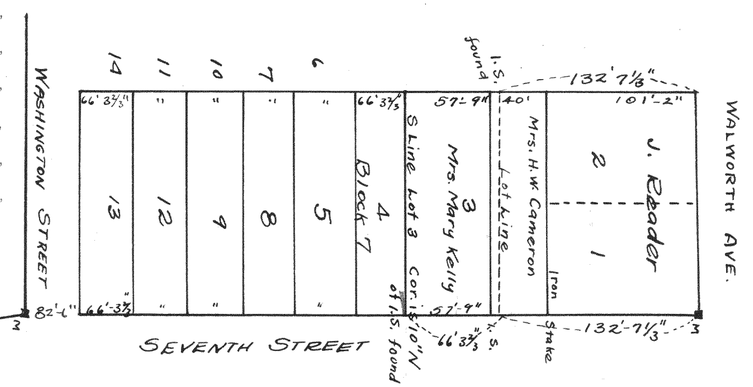

Plat of a survey made for Mrs. Mary Kelly and Mrs. H. W. Cameron of Delavan to locate the corners of their lots, Being a portion of lot No. 3 for Mrs. Kelly and a portion of Lots 1, 2, & 3 for Mrs. Cameron of Block 7 of The Passage Aram and Downey Addition in the City of Delavan, Walworth County, Wisconsin.

The lines of the Block were run according to Monuments set by the City Engineer and I find in the East line of the Block an overrun of 33', giving each lot of 66 feet, 66' 3⅓" in width

Survey made April 25th 1931


Wm. CHILD
County Surveyor

Recorded by Floyd S. Jensen Co. Sur.

NAMES OF SWORN ASSISTANTS

CHAINMEN	FLAGMEN	AXMEN

No. 611 Block 4 of Passage-Aram-Downie's Add. City of Delavan

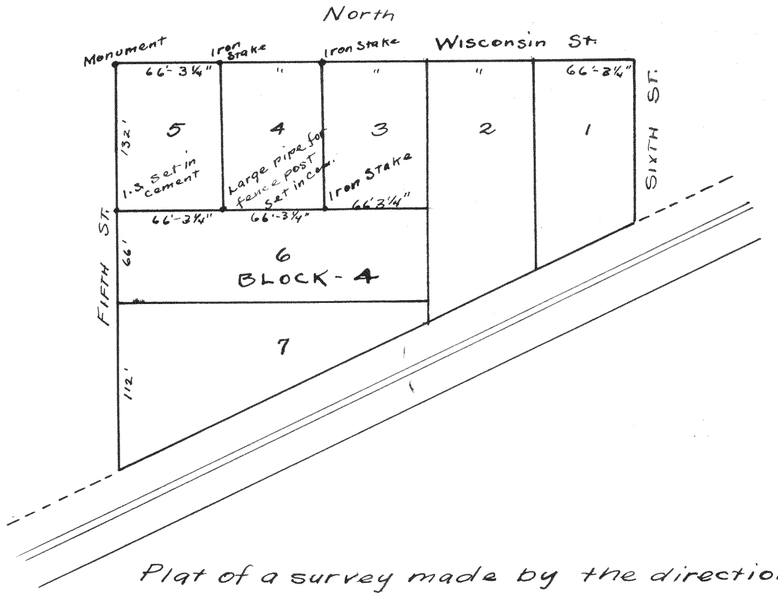


Plat of a survey made by the direction of Thos. J. Sorenson of Delavan to locate the corners of Lots 4 & 5 of Block 4 of Passage Aram-Downies Addition in the City of Delavan, Walworth County, Wisconsin. The lines of the block were Ran according to the Monuments set by the City Engineer, and I find in the North line of the Block an overrun of 17" (or 14") giving each lot 66' 3¼" in width. Survey made April 24th 1931

Wm. CHILD
County Surveyor

Recorded by Floyd S. Jensen
Co. Surv.

612- N.E. ¼ Sec. 26, T4N, R17E

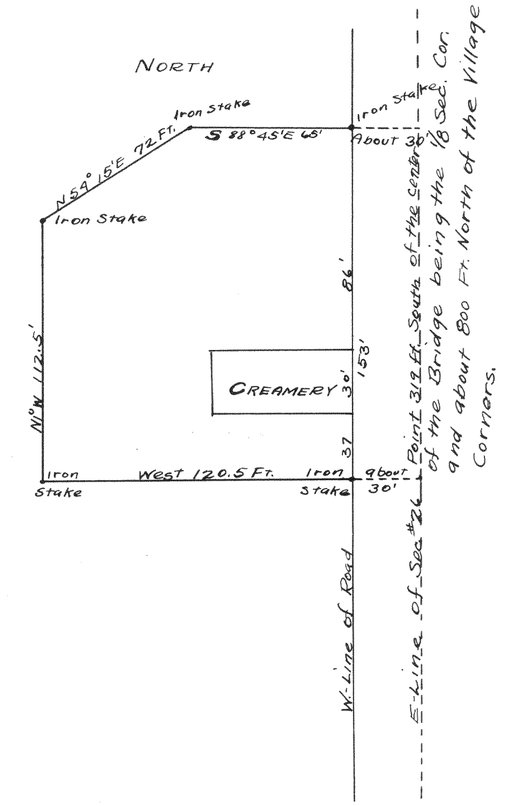

Plat of the property of the Jonsen Creamery Company located in the North East Quarter of Sec. No. 26, Town No. 4 North, Range No. 17 East being the Town of Troy, Walworth County, Wisconsin.
ELKHORN - Dec. 5, 1925

Wm. Child
Co. Surveyor

Recorded by Floyd S. Jensen
Co. Surv.