# Record of Survey.


No. 613 34 - 3 - 18

Township....., North of Range.....of 4 Principal Meridian as presented by the courses and distances on the following plat, and annexed field-notes of survey:

Established the center of the section at the point of intersection of STRAIGHT quarter lines.

Estabished all quarter-quarter corners upon the section boundary at proportional distances between known section and quarter section corners, according to the original field-notes of the Government survey.

Established all lost corners at proportionate distances between known corners, according to the original field notes of the Government survey.

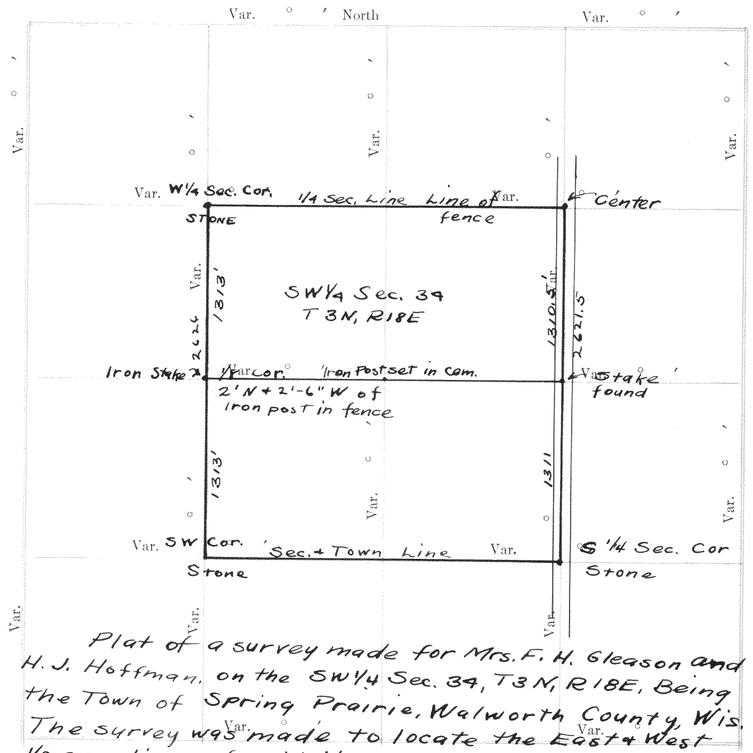



Plat of Section....., Township.....North, Range.....of 4 Principal Meridian Scale 80 chains to 6 inches. The figures in red ink are the lengths of the lines as stated in the field-notes of the Government survey.

Survey made April, 1931

Wm. Child
Co. Surveyor

Declination of the Magnetic Meridian from the True Meridian.....

Surveyed and sub-divided.....A. D. 19....., in accordance with the State Laws and Instructions of the Commissioner of the General Land office, and recorded on pages .....of Register in the County Clerk's office.

Recorded by Lloyd S. Jensen
Co. Sur.

**Witness** my hand this.....day of.....A. D. 1


.....SURVEYOR.

# DESCRIPTION

## OF SECTION, QUARTER SECTION AND QUARTER QUARTER SECTION CORNERS

H. C. MILLER CO., MFG. STATIONERS, MILWAUKEE X15000

| GOVERNMENT CORNERS | Bearing Trees | In. Dia. | Courses they bear | Links Distant | Bearing Trees | In. Dia. | Courses they bear | Links Distant | Bearing Trees | In. Dia. | Courses they bear | Links Distant | Bearing Trees | In. Dia. | Courses they bear | Links Distant |
|---|---|---|---|---|---|---|---|---|---|---|---|---|---|---|---|---|
| No. | | | | | | | | | | | | | | | | |
| 1. N. W. Sec. Cor. indentified, | | | | | | | | | | | | | | | | |
| 2. N. E. Sec. Cor. indentified, | | | | | | | | | | | | | | | | |
| 3. S. E. Sec. Cor. indentified, | | | | | | | | | | | | | | | | |
| 4. S. W. Sec. Cor. indentified, | | | | | | | | | | | | | | | | |
| 5. N. 1/4 Sec. Cor. indentified, | | | | | | | | | | | | | | | | |
| 6. E. 1/4 Sec. Cor. indentified, | | | | | | | | | | | | | | | | |
| 7. S. 1/4 Sec. Cor. indentified, | | | | | | | | | | | | | | | | |
| 8. W. 1/4 Sec. Cor. indentified, | | | | | | | | | | | | | | | | |
| **Subdivision Corners** | | | | | | | | | | | | | | | | |
| No. | | | | | | | | | | | | | | | | |
| 1. Center 1/4 Sec. Cor. | | | | | | | | | | | | | | | | |
| 2. North 1/4-1/8 s N. W. qr., | | | | | | | | | | | | | | | | |
| 3. East 1/4-1/8 s N. W. qr., | | | | | | | | | | | | | | | | |
| 4. South 1/4-1/8 s N. W. qr., | | | | | | | | | | | | | | | | |
| 5. West 1/4-1/8 s N. W. qr., | | | | | | | | | | | | | | | | |
| 6. Center 1/4-1/8 s N. W. qr., | | | | | | | | | | | | | | | | |
| 7. North 1/4-1/8 s N. E. qr., | | | | | | | | | | | | | | | | |
| 8. East 1/4-1/8 s N. E. qr., | | | | | | | | | | | | | | | | |
| 9. South 1/4-1/8 s N. E. qr., | | | | | | | | | | | | | | | | |
| 10. Center 1/4-1/8 s N. E. qr., | | | | | | | | | | | | | | | | |
| 11. East 1/4-1/8 s S. E. qr., | | | | | | | | | | | | | | | | |
| 12. South 1/4-1/8 s S. E. qr., | | | | | | | | | | | | | | | | |
| 13. West 1/4-1/8 s S. E. qr., | | | | | | | | | | | | | | | | |
| 14. Center 1/4-1/8 s S. E. qr., | | | | | | | | | | | | | | | | |
| 15. South 1/4-1/8 s S. W. qr., | | | | | | | | | | | | | | | | |
| 16. West 1/4-1/8 s S. W. qr., | | | | | | | | | | | | | | | | |
| 17. Center 1/4-1/8 s S. W. qr. | | | | | | | | | | | | | | | | |

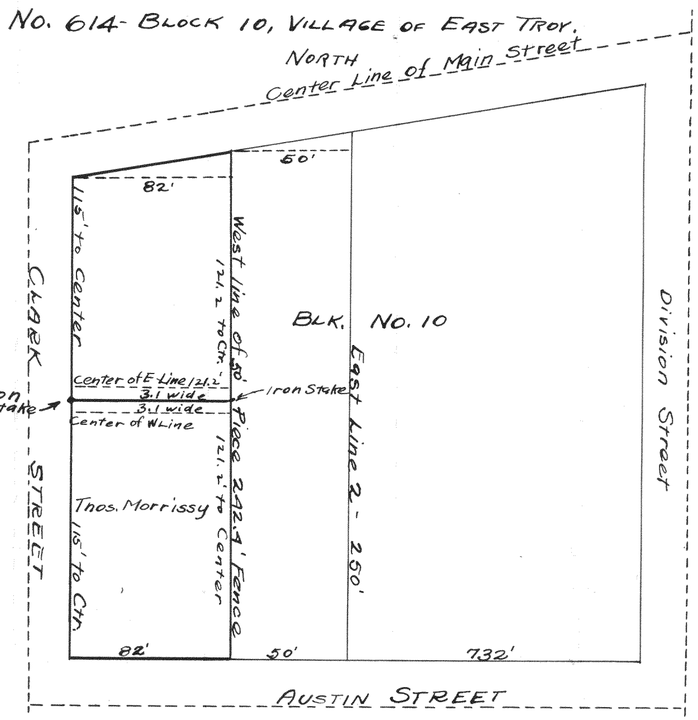



Plat of a survey made for Thos. Morrissy of East Troy to divide the West 82 feet of Lot No. 2 of Block No. 10 of the Village of East Troy, Walworth County, Wis., in two equal parts by a line running East & West thru the same, as shown on the plat.
East Troy, Nov. 1st 1932 Wm. Child
County Surveyor

Recorded by Lloyd S. Jensen
Co. Sur.

NAMES OF SWORN ASSISTANTS

CHAINMEN FLAGMEN AXMEN

## No. 615. N.E. 1/4 Sec. 17, - 2 - 16 - City of Delavan

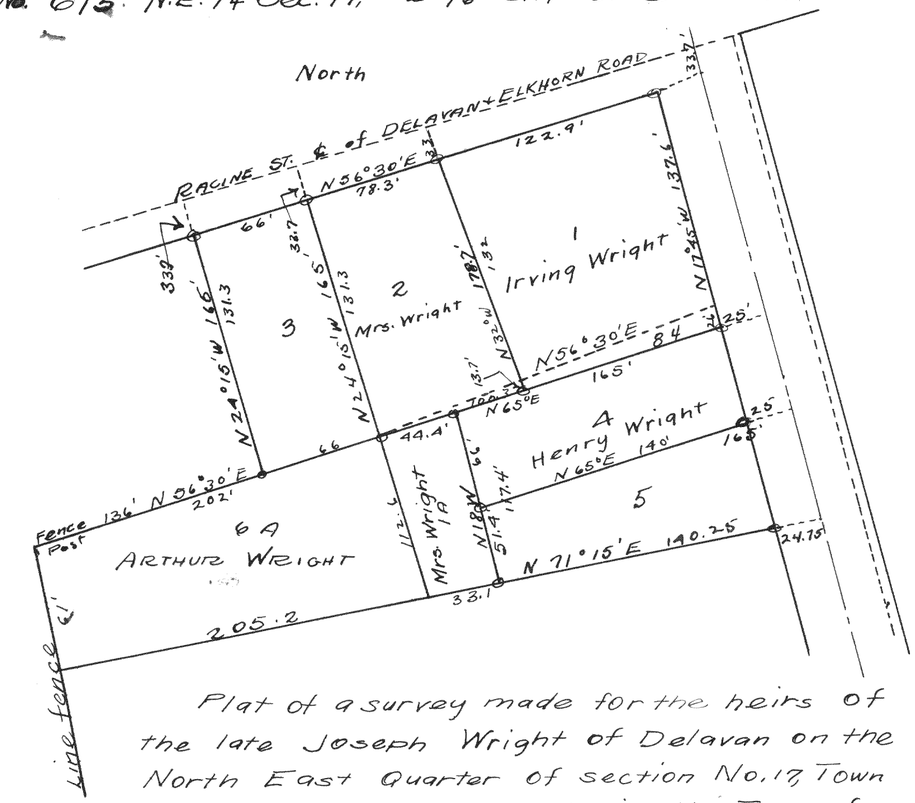



Plat of a survey made for the heirs of the late Joseph Wright of Delavan on the North East Quarter of section No. 17, Town 2 North Range 16 East, being the Town of Delavan, Walworth County, Wisconsin. Iron stakes at all corners marked o

Elkhorn, April 26, 1928

Wm. Child,
County Surveyor
Recorded by Floyd P. Jensen
Co. Sur.

## No. 616 - 4 + 9 - 4 - 17

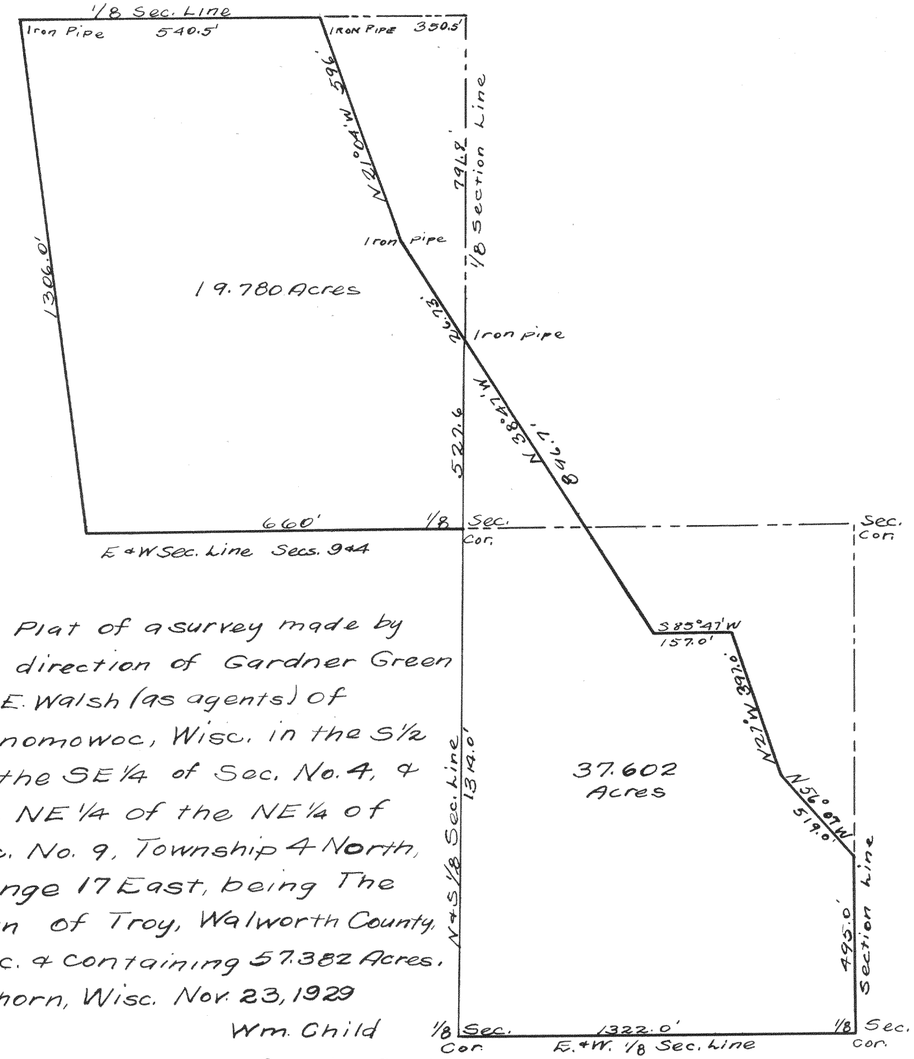


Plat of a survey made by the direction of Gardner Green & L. E. Walsh (as agents) of Oconomowoc, Wisc. in the S 1/2 of the SE 1/4 of Sec. No. 4, & the NE 1/4 of the NE 1/4 of Sec. No. 9, Township 4 North, Range 17 East, being The Town of Troy, Walworth County, Wisc. & containing 57.382 Acres.

Elkhorn, Wisc. Nov. 23, 1929

Wm. Child
County Surveyor,
Recorded by Floyd P. Jensen
Co. Sur.