Record of Survey.


Township....., North of Range.....of 4 Principal Meridian as presented by the courses and distances on the following plat, and annexed field-notes of survey:

Established the center of the section at the point of intersection of STRAIGHT quarter lines.


Established all quarter-quarter corners upon the section boundary at proportional distances between known section and quarter section corners, according to the original field-notes of the Government survey.

Established all lost corners at proportionate distances between known corners, according to the original field notes of the Government survey.

no. 643

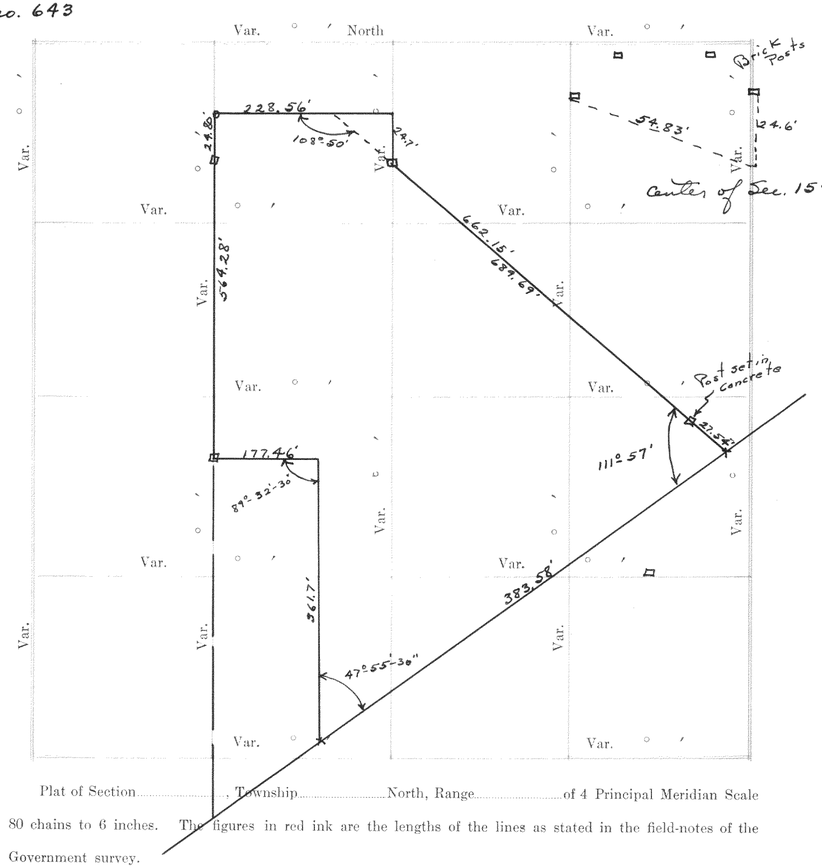
Var.
North
Var.
Var.
Var.

No. 644

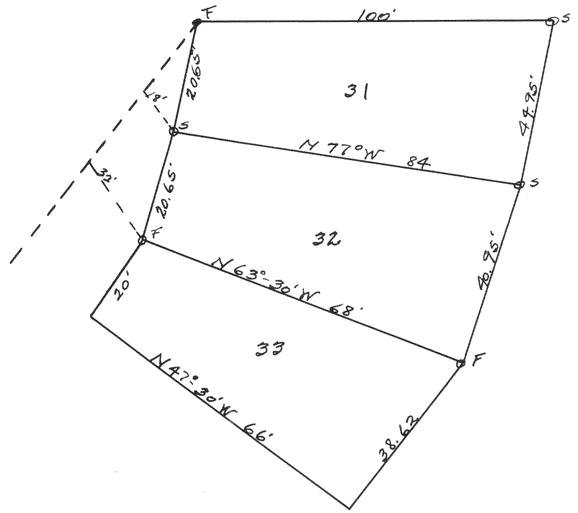


Survey of lots 31 and 32 of Buena Vista Park, located in Fontana, Wisconsin
Points marked F were points found in the field.
" " S " " set.
Line between lot 31 and 32 was set by bearing and distances.

July 1935 Lloyd V. Jensen
Co. Surveyor.

No. 645

Block 100 of Lake Waubawega Subdivision

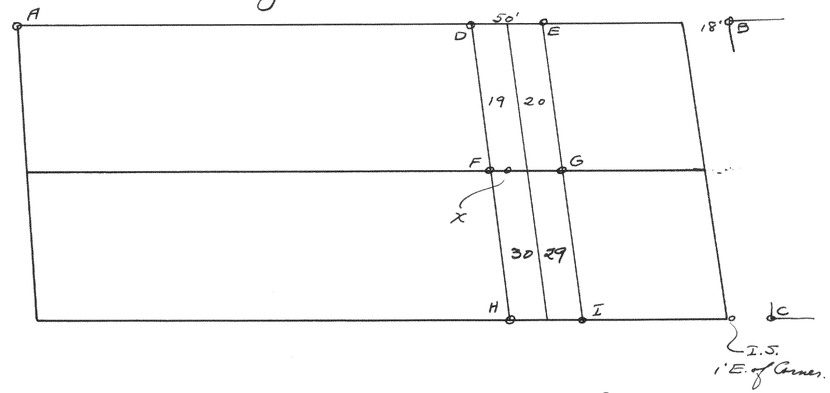

Stakes at corners of blocks marked A, B & C used in this survey.
Iron stake found at point marked X, was set by turning off a Rt. ∠ from the front line of the Block.
Set iron stakes at D, E, F, G, H and I which are the corners of lots 19, 20, 30 and 29.

July 1935 Lloyd V. Jensen
County Surveyor.