Record of Survey.


Township....., North of Range.....of 4 Principal Meridian as presented by the courses and distances on the following plat, and annexed field-notes of survey:

Established the center of the section at the point of intersection of STRAIGHT quarter lines.

Established all quarter-quarter corners upon the section boundary at proportional distances between known section and quarter section corners, according to the original field-notes of the Government survey.

Established all lost corners at proportionate distances between known corners, according to the original field notes of the Government survey.

No. 648

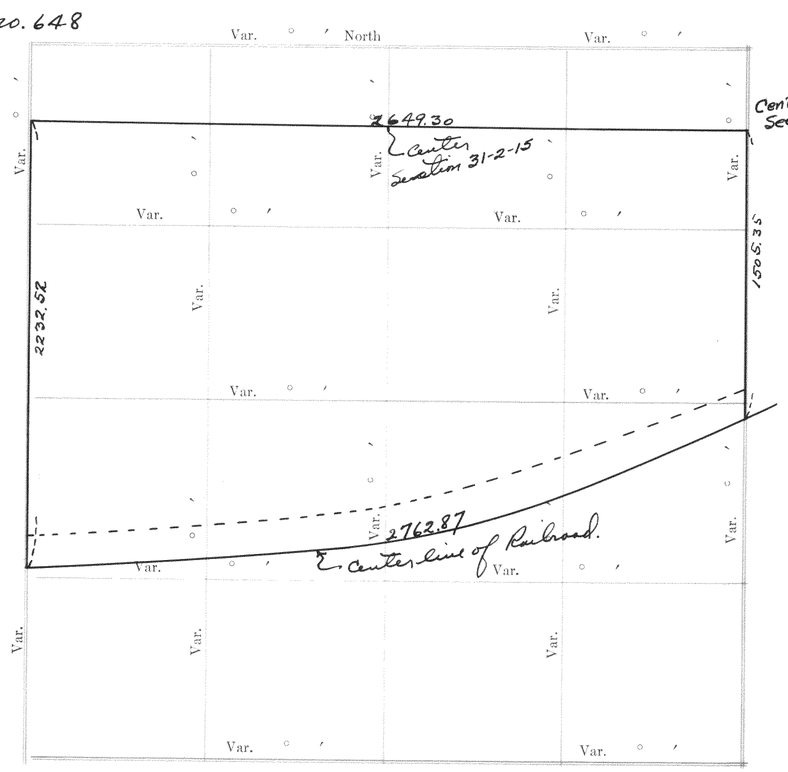
Var. ° ′ North
Var. ° ′
Var.
Var.
Var.

no. 649


This was a survey of the SE¼ of Section 14 and the SE¼ of NW¼ of Section 14, T31N, R17E. Survey was made of the fence lines for area only, no permanent corners were located.

Jan. 1936

Lloyd V. Jensen
Co. Surveyor

no. 650

Survey of lot 21 and part of lot 20 of "The Gardens" Subd., Fontana, Wisconsin.

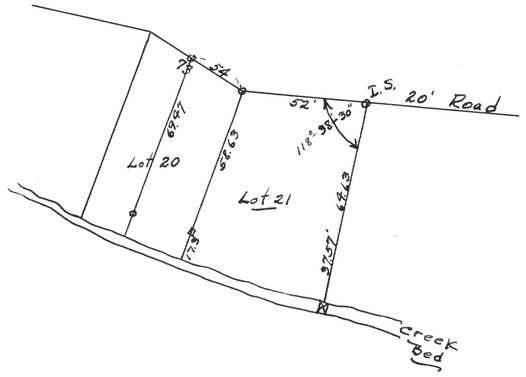

Iron stake placed at point marked (O)

Oct. 26-28, 1935

Lloyd V. Jensen
Co. Surveyor

no. 651


Survey for C. C. Carnahan in Sec. 36, T47N, R16E to show the location of the road lying along the East side of the section. It was the centerline of the road that lies along the top of the dam.

July 1935

Lloyd V. Jensen
County Surveyor.

no. 652

Survey of that portion of the lake that lies outside the Southerly line of the land owned by C. C. Carnahan in Section 36, T47N, R16E

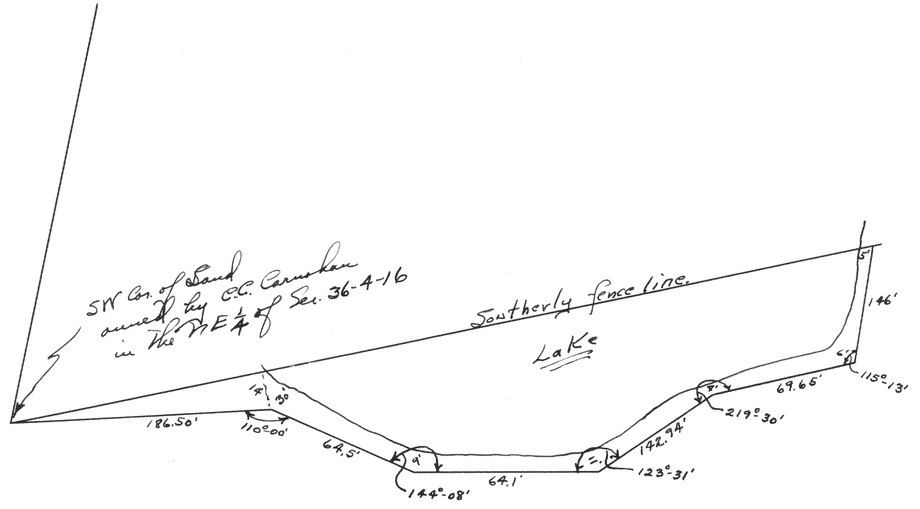

July 1935

Lloyd V. Jensen
County Surveyor