No. 656

Accident notes for Earlin Johnson, at the intersection of Newcomb Street and the Railroad. Building and oil tanks were located from the railroad South to the concrete road known as Milwaukee Street. Elevations were taken on the centerline of Newcomb Str. from Mil. Street to the Railroad.

No lot or block corners were located.

Nov. 1935

Floyd V. Jensen
County Surveyor.

No. 657


Levels for A. J. Reed in Section 25, T37N, R16E for a tile line.

Elevations were taken and stakes graded in the field no profiles were drawn.

July 1935

Floyd V. Jensen
Co. Surveyor.

No. 658

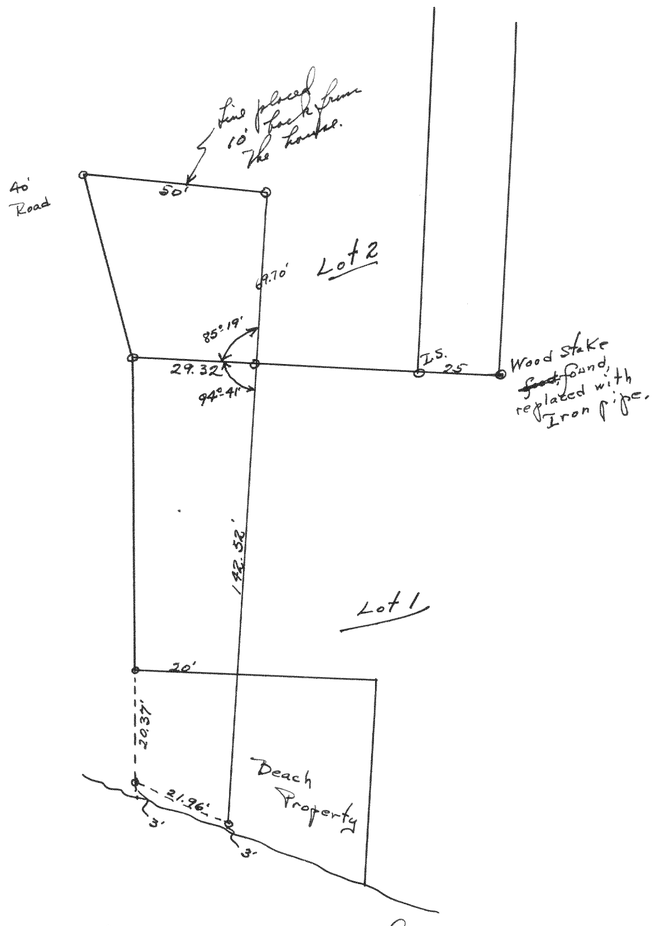

Survey of part of lots 142 of block 2 of Woodale Add. in Section 9, T1N, R17E. Lines were extended onto part of the public beach lot.

Aug. 1935

Floyd V. Jensen
County Surveyor