Record of Survey.

No. 48


Township....., North of Range.....of 4 Principal Meridian as presented by the courses and distances on the following plat, and annexed field-notes of survey.

Survey of lot 17 for Mrs. Forester in Morris Park on Green Lake

Established the center of the section at the point of intersection of straight quarter lines.

Established all quarter quarter corners upon the section boundary at proportional distances between known section and quarter section corners, according to the original field-notes of the Government survey.

Established all lost corners at proportionate distances between known corners, according to the original field notes of the Government survey.

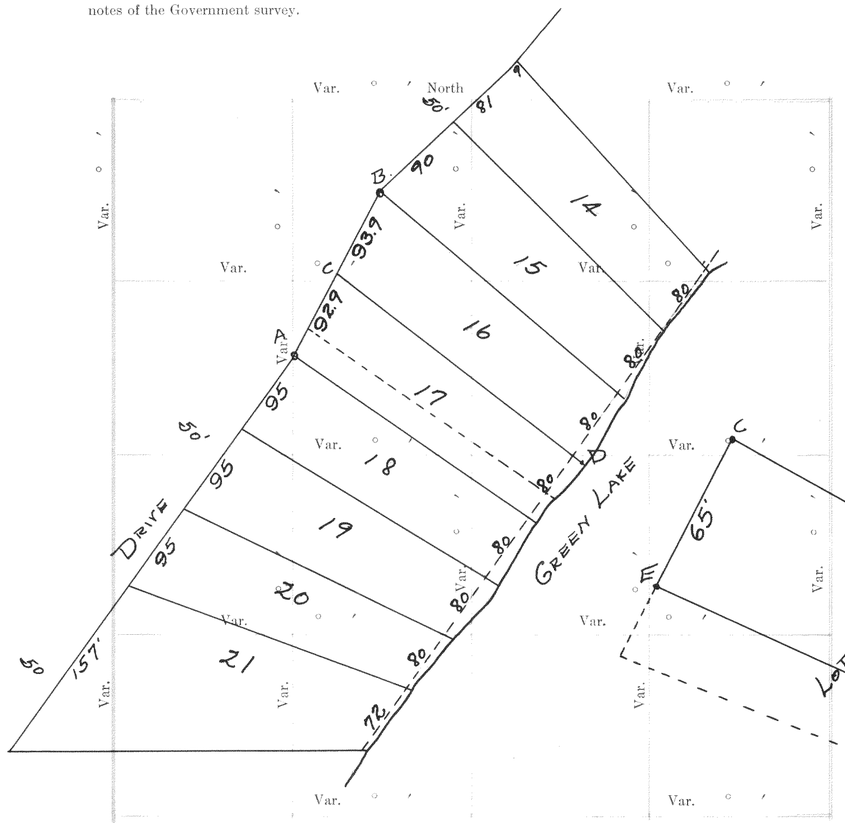

Plat of Section....., Township.....North, Range.....of 4 Principal Meridian Scale 80 chains to 6 inches. The figures in red ink are the lengths of the lines as stated in the field-notes of the Government survey.

Declination of the Magnetic Meridian from the True Meridian.....

Surveyed and sub-divided.....A. D. 1 , in accordance with the State Laws and Instructions of the Commissioner of the General Land office, and recorded on pages .....of Register in the County Clerk's office.

Witness my hand this.....day of.....A. D. 1

.....SURVEYOR.

DESCRIPTION

OF SECTION, QUARTER SECTION AND QUARTER QUARTER SECTION CORNERS

H. C. MILLER CO., MFG. STATIONERS, MILWAUKEE X15000

GOVERNMENT CORNERS	Bearing Trees	In. Dia.	Courses they bear	Links Distant	Bearing Trees	In. Dia.	Courses they bear	Links Distant	Bearing Trees	In. Dia.	Courses they bear	Links Distant	Bearing Trees	In. Dia.	Courses they bear	Links Distant
No. 1. N. W. Sec. Cor. indentified,																
2. N. E. Sec. Cor. indentified,																
3. S. E. Sec. Cor. indentified,																
4. S. W. Sec. Cor. indentified,																
5. N. ¼ Sec. Cor. indentified,																
6. E. ¼ Sec. Cor. indentified,																
7. S. ¼ Sec. Cor. indentified,																
8. W. ¼ Sec. Cor. indentified,																
Subdivision Corners																
No. 1. Center ¼ Sec. Cor.																
2. North ¼-¼s N. W. qr.,																
3. East ¼-¼s N. W. qr.,																
4. South ¼-¼s N. W. qr.,																
5. West ¼-¼s N. W. qr.,																
6. Center ¼-¼s N. W. qr.,																
7. North ¼-¼s N. E. qr.,																
8. East ¼-¼s N. E. qr.,																
9. South ¼-¼s N. E. qr.,																
10. Center ¼-¼s N. E. qr.,																
11. East ¼-¼s N. E. qr.,																
12. South ¼-¼s S. E. qr.,																
13. West ¼-¼s S. E. qr.,																
14. Center ¼-¼s S. E. qr.,																
15. South ¼-¼s S. W. qr.,																
16. West ¼-¼s S. W. qr.,																
17. Center ¼-¼s S. W. qr.																

Survey of Fil lot 17 of Morris Park, T41N, R16E
Located iron pipes at pts A & B. as set by former County Surveyor Mr. Child. Sighted between these two pts & set pt. C which is a pipe set in concrete
Looked for the base line on the shore but could find no evidence of stakes. Scaled the distance from a map to locate the approximate position of ton lots 14, 15 & 16. Measured 240 feet & this measurement checked within .08 ons N. line of lot 17 using pt C & the SE. fence post as last fence post toward the lake between lots 16 & 17.
In locating the N. line of lot 17 I used pt C & the E. of the fence post, this locates pt D .08' N of the back house wall. It is an iron pin in concrete.
Measuring on the approximate base line 55 feet made & located pt E. the S line of Mrs. Foresters lot.
Measured 65' 5 from C and located pt E. G & H are markers about midway on the lot.
All markers are iron pins or pipes in concrete, set flush with the ground.


Surveyed March 7 & 9, 1933
Floyd F. Jensen
County Surveyor

NAMES OF SWORN ASSISTANTS

CHAINMEN	FLAGMEN	AXMEN

No. 49

Survey of Sylvia Gray Estate in Block 26, original town of Elkhorn

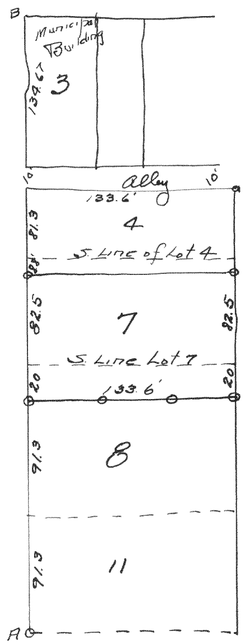

Description of parcel surveyed


Beginning at a pt. 82.5 N. of the SE. Cor. of Lot 7, Block 26 of the original town of Elkhorn, Walworth Co. Wisconsin, thence West parallel with the S. line of Lot 7 to a pt. on the West line of Lot 7 82.5 feet N. of the S.W. Cor. of Lot 7, thence South 102.5 feet to a pt. 20' S. of the SW. Cor. of Lot 7, thence E to a pt. on the E. line of Lot 8, 20 feet South of the SE. Cor. of Lot 7, thence North 102.5 feet to the place of beginning.

Found iron pipe at A about 2" under surface. At B. the block cor. is a crows foot in the side walk, but have been placed by Mr. Tubbs, City Engineer of Elkhorn.

Dec. 9, 1933

Floyd S. Jensen
Co. Surv.

No. 50

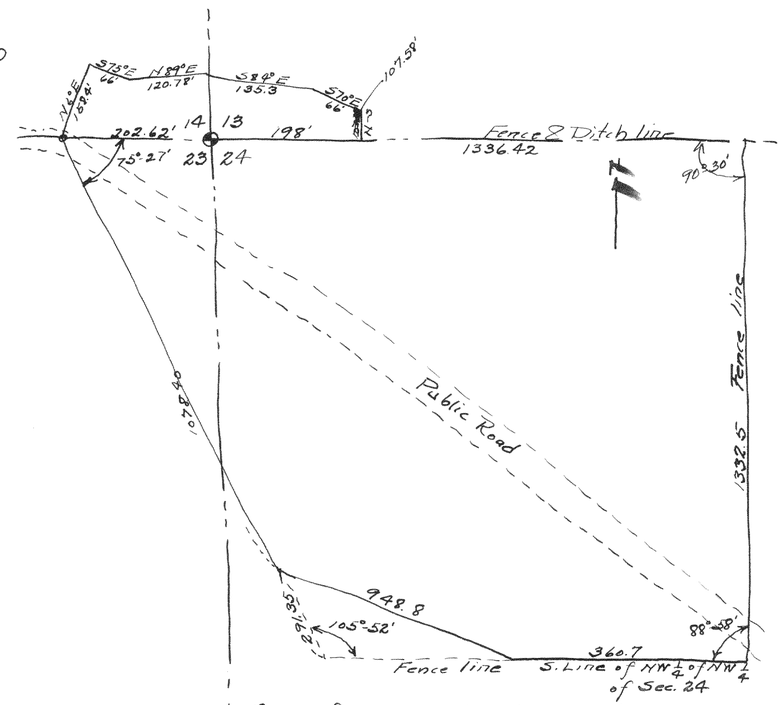

Survey of Frank B. Hart & Dr. Homestead located in Sections 13, 14, 23 & 24 of T4N, R18E.

Description:

Commencing at the sec. cor. common to sections, 13, 14, 23 & 24 of T4N, R18E, thence N. 202.62 feet to an iron pipe, which is the place of beginning; thence S 14°-33' E. 1078.40' to an iron pipe; thence Southeasterly 948.80' to a pt. 360.7' West of the SE. corner of NW¼ of NW¼ of Section 24, thence E. 360.7'; thence N. 1332.5' to a pt. in the S of the drainage ditch, thence W. 1138.42' to a pt., thence N. 107.58' thence N 70°-W 66'; thence N 84° W 135.3', thence S89°W 120.78', thence N 75°W 66', thence S6°W 158.4' to the place of beginning - containing 40 Acres of land.

Found welding old stake at sec. cor. 13, 14, 23 & 24, and placed Iron Pipe in its place.

May 22, 1933

Floyd S. Jensen
Co. Surv.