No. 682

Survey and construction notes for The Borg Dam located in Section 20, T2N, R16E.

June to Dec. 1934

Floyd V. Jensen
County Surveyor.


No. 683

Survey of lots 8 & 9 of Block 8 of Tripp's 2nd. Addition to the City of Whitewater, Wis. No stakes were found, measurments were taken from fences and sidewalks. This survey was made to locate the bounds approximately for grading purposes for a skating rink.

April 1935

Floyd V. Jensen
County Surveyor

No. 684 Survey to locate the house on lot 7 of Mereness Springs and lot 1 of Sam Sauci, located in Section 22, T2N, R16E.

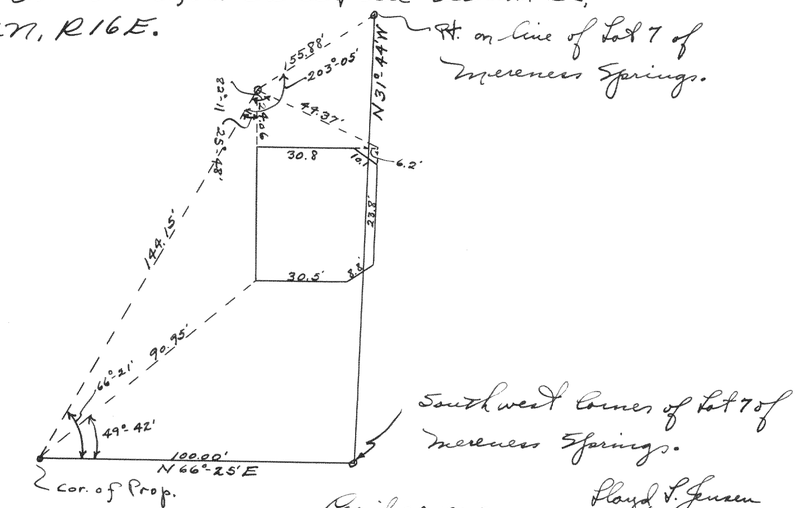

April 24, 1935

Floyd V. Jensen
County Surveyor

No. 685

Survey of the intersection of St. Trunk highway 89 and St. Trunk highway 15. Survey was made to locate all of the physical objects within the area of the corner and 300' South and 200' West. The location of the Lot corner as the Northeast corner of the intersection was gotten from survey no. 628.

Notes were plotted and were used in an auto accident suit.

April 1935

Floyd V. Jensen
Co. Surveyor.

No. 686

Survey to locate the physical features at the intersection of State Trunk Highway 89 and County Trunk Highway "O" located in Section 7, T1N, R16E. Notes were plotted and the map was as evidence in an auto accident case, at Walworth County Circuit Courtroom.

April 1935

Floyd V. Jensen
County Surveyor