Record of Survey.


Township....., North of Range.....of 4 Principal Meridian as presented by the courses and distances on the following plat, and annexed field-notes of survey:

Established the center of the section at the point of intersection of STRAIGHT quarter lines.

Established all quarter-quarter corners upon the section boundary at proportional distances between known section and quarter section corners, according to the original field-notes of the Government survey.

Established all lost corners at proportionate distances between known corners, according to the original field notes of the Government survey.

No. 701

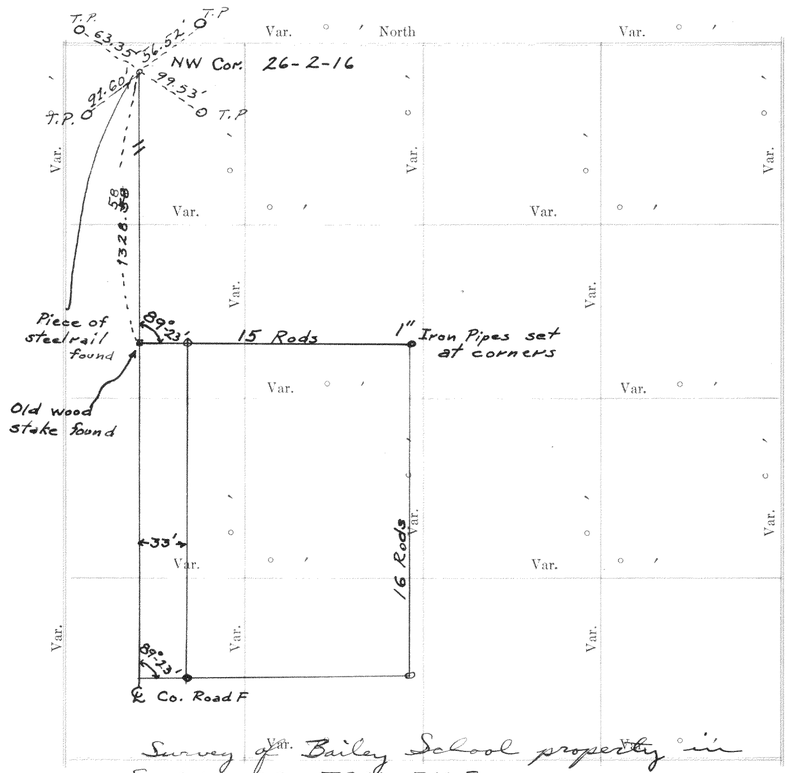

Survey of Bailey School property in Section 26, T24, R16 E. September 1936

Plat of Section....., Township.....North, Range.....of 4 Principal Meridian Scale 80 chains to 6 inches. The figures in red ink are the lengths of the lines as stated in the field-notes of the Government survey.

Recorded by W. E. H. Lloyd L. Jensen Co. Surveyor

Declination of the Magnetic Meridian from the True Meridian.....

Surveyed and sub-divided.....A. D. 1 , in accordance with the State Laws and Instructions of the Commissioner of the General Land office, and recorded on pages .....of Register in the County Clerk's office.

Witness my hand this.....day of.....A. D. 1


.....SURVEYOR.

DESCRIPTION

OF SECTION, QUARTER SECTION AND QUARTER QUARTER SECTION CORNERS

N. C. MILLER CO., MFG. STATIONERS, MILWAUKEE X15000

GOVERNMENT CORNERS	Bearing Trees	In. Dia.	Courses they bear	Links Distant	Bearing Trees	In. Dia.	Courses they bear	Links Distant	Bearing Trees	In. Dia.	Courses they bear	Links Distant	Bearing Trees	In. Dia.	Courses they bear	Links Distant
No.																
1. N. W. Sec. Cor. indentified,	No. 702															
2. N. E. Sec. Cor. indentified,																
3. S. E. Sec. Cor. indentified,																
4. S. W. Sec. Cor. indentified,																
5. N. ¼ Sec. Cor. indentified,																
6. E. ¼ Sec. Cor. indentified,																
7. S. ¼ Sec. Cor. indentified,																
8. W. ¼ Sec. Cor. indentified,																
Subdivision Corners																
No.																
1. Center ¼ Sec. Cor.																
2. North ¼-⅛s N. W. qr.,																
3. East ¼-⅛s N. W. qr.,																
4. South ¼-⅛s N. W. qr.,																
5. West ¼-⅛s N. W. qr.,																
6. Center ¼-⅛s N. W. qr.,																
7. North ¼-⅛s N. E. qr.,																
8. East ¼-⅛s N. E. qr.,																
9. South ¼-⅛s N. E. qr.,																
10. Center ¼-⅛s N. E. qr.,																
11. East ¼-⅛s S. E. qr.,																
12. South ¼-⅛s S. E. qr.,																
13. West ¼-⅛s S. E. qr.,																
14. Center ¼-⅛s S. E. qr.,																
15. South ¼-⅛s S. W. qr.,																
16. West ¼-⅛s S. W. qr.,																
17. Center ¼-⅛s S. W. qr.																

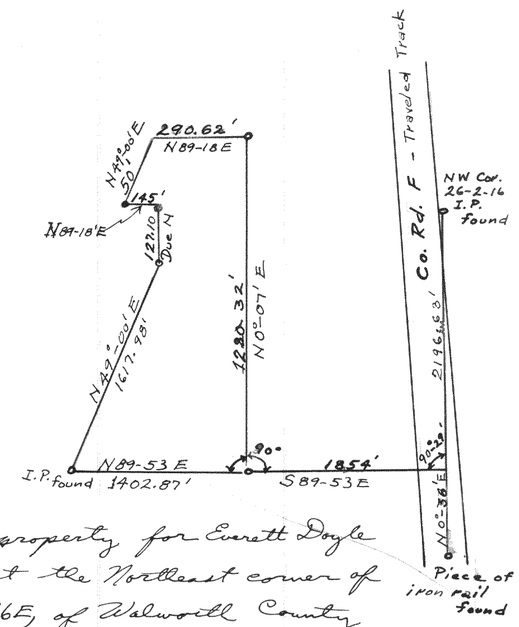


Survey of Amerpohl property for Everett Doyle which commences at the Northeast corner of Section 27, T24, R16E, of Walworth County, Wisconsin; thence S 0°-36' W along the East line of said Section 2196.63 feet to a point; thence N 89°-53' W 1854.0 feet to an iron pipe at the place of beginning; thence N 0°-07' E 1220.32 feet; thence S 89°-18' W 290.62 feet to a point in the center of Public road; thence S 49°-00' W 50.0 feet along the center line of said road; thence N 89°-18' E 145.0 feet, thence due South 127.10 feet; thence S 49°-00' W 1617.98 feet; thence N 89°-53' E 1402.87' to the place of beginning containing 20.02 acres of land.

NAMES OF SWORN ASSISTANTS

CHAINMEN	FLAGMEN	AXMEN
	September 1936	


Lloyd L. Jensen
Co. Surveyor
Recorded by W. E. H.

No. 703

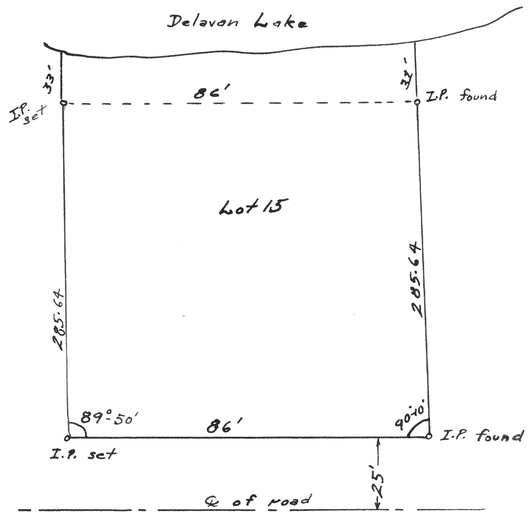

Survey of the Southerly 86 feet of Lot 15 of Belrock Subdivision, for Belrock Sportsmen's Association
September, 1936 Lloyd L. Jensen
Co. Surveyor
Recorded by W. E. H.

No. 703-a

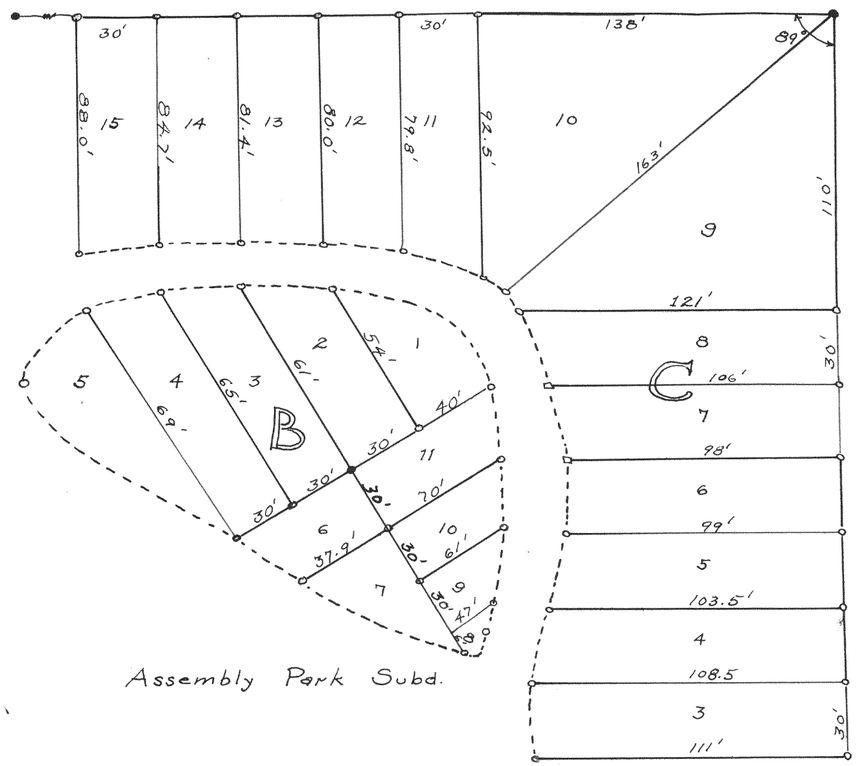

Assembly Park Subd.

- Iron pipes found
- o " " set
- □ Wood stakes or mark found.

Survey for Assembly Park Association.
Lots 3-15 inclusive in Block C were surveyed and Block B was laid out for park purposes as shown by taking 5' from all the lots thus making the road around Block B 20' wide. It was formerly 15' wide.

Sept. 1936

Lloyd L. Jensen
Co. Surveyor
Recorded by W. E. H.