Record of Survey.


Township....., North of Range.....of 4 Principal Meridian as presented by the courses and distances on the following plat, and annexed field-notes of survey:

Established the center of the section at the point of intersection of STRAIGHT quarter lines.

Established all quarter-quarter corners upon the section boundary at proportional distances between known section and quarter section corners, according to the original field-notes of the Government survey.

Established all lost corners at proportionate distances between known corners, according to the original field notes of the Government survey.

No. 704

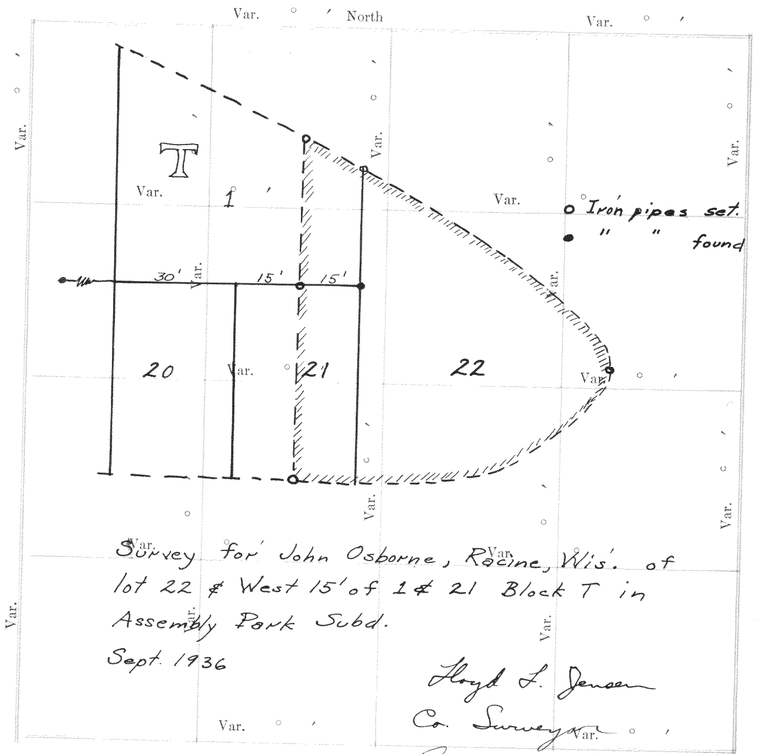

Plat of Section....., Township.....North, Range.....of 4 Principal Meridian Scale 80 chains to 6 inches. The figures in red ink are the lengths of the lines as stated in the field-notes of the Government survey.

Declination of the Magnetic Meridian from the True Meridian.....

Surveyed and sub-divided.....A. D. 1 , in accordance with the State Laws and Instructions of the Commissioner of the General Land office, and recorded on pages .....of Register in the County Clerk's office.

Witness my hand this.....day of.....A. D. 1

.....SURVEYOR.

DESCRIPTION

227


OF SECTION, QUARTER SECTION AND QUARTER QUARTER SECTION CORNERS

H. C. MILLER CO., MFG. STATIONERS, MILWAUKEE X15000

GOVERNMENT CORNERS	Bearing Trees	In. Dia.	Courses they bear	Links Distant	Bearing Trees	In. Dia.	Courses they bear	Links Distant	Bearing Trees	In. Dia.	Courses they bear	Links Distant	Bearing Trees	In. Dia.	Courses they bear	Links Distant
No.																
1. N. W. Sec. Cor. indentified,																
2. N. E. Sec. Cor. indentified,																
3. S. E. Sec. Cor. indentified,																
4. S. W. Sec. Cor. indentified,																
5. N. ¼ Sec. Cor. indentified,																
6. E. ¼ Sec. Cor. indentified,																
7. S. ¼ Sec. Cor. indentified,																
8. W. ¼ Sec. Cor. indentified,																
Subdivision Corners																
No.																
1. Center ¼ Sec. Cor.																
2. North ¼-⅛s N. W. qr.,																
3. East ¼-⅛s N. W. qr.,																
4. South ¼-⅛s N. W. qr.,																
5. West ¼-⅛s N. W. qr.,																
6. Center ¼-⅛s N. W. qr.,																
7. North ¼-⅛s N. E. qr.,																
8. East ¼-⅛s N. E. qr.,																
9. South ¼-⅛s N. E. qr.,																
10. Center ¼-⅛s N. E. qr.,																
11. East ¼-⅛s S. E. qr.,																
12. South ¼-⅛s S. E. qr.,																
13. West ¼-⅛s S. E. qr.,																
14. Center ¼-⅛s S. E. qr.,																
15. South ¼-⅛s S. W. qr.,																
16. West ¼-⅛s S. W. qr.,																
17. Center ¼-⅛s S. W. qr.																

No. 705

Cisco Beach Subd.

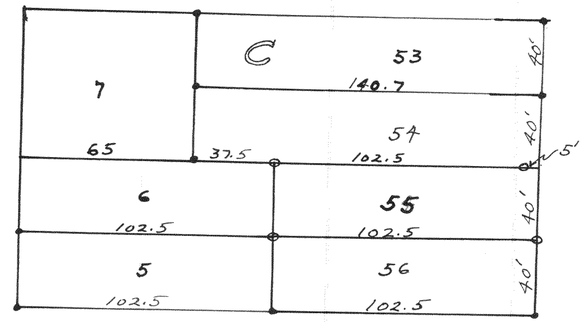

o Iron pipes set
• " pins found

Survey of Lot 55, Block C of Cisco Beach Subd. for L. C. Schuster of Chicago, Illinois.

Sept. 1936

Floyd L. Jensen
Co. Surveyor
Recorded by W. E. H.

CHAINMEN


NAMES OF SWORN ASSISTANTS

FLAGMEN

AXMEN

227

No. 706

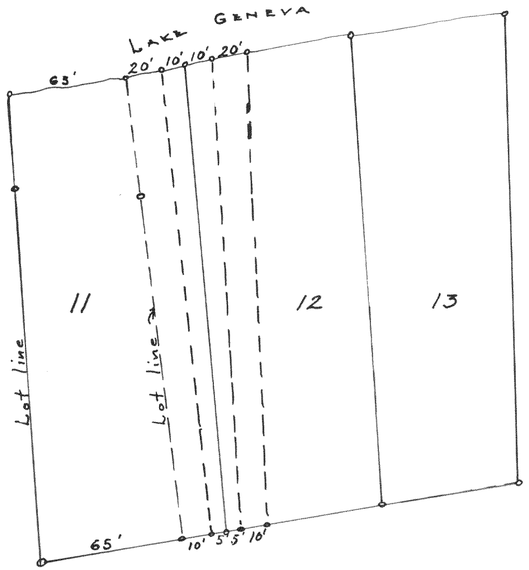

Woodale Add. Block 1

Survey of lot 11, Block 1 for Arthur B. Jensen with right of ways taken off Lots 11 & 12 as shown by dotted lines.


Sept. 29, 1936

Lloyd L. Jensen
Co. Surveyor
Recorded by W.C.H.

No. 706 a

Woodale Add- Lake Geneva

● Iron pipes placed
c Iron pins found
O " pipes "

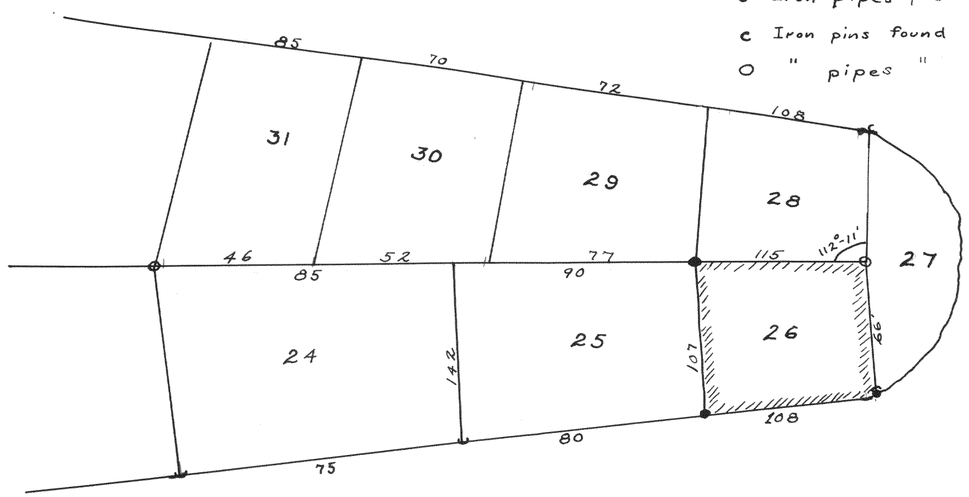

Survey of Lot 26, Block 3 for Arthur B. Jensen

Sept. 29, 1936

Lloyd L. Jensen
Co. Surveyor
Recorded by W.C.H.