Record of Survey.


Township....., North of Range.....of 4 Principal Meridian as presented by the courses and distances on the following plat, and annexed field-notes of survey:

Established the center of the section at the point of intersection of STRAIGHT quarter lines.


Established all quarter-quarter corners upon the section boundary at proportional distances between known section and quarter section corners, according to the original field-notes of the Government survey.

Established all lost corners at proportionate distances between known corners, according to the original field notes of the Government survey.

No. 707

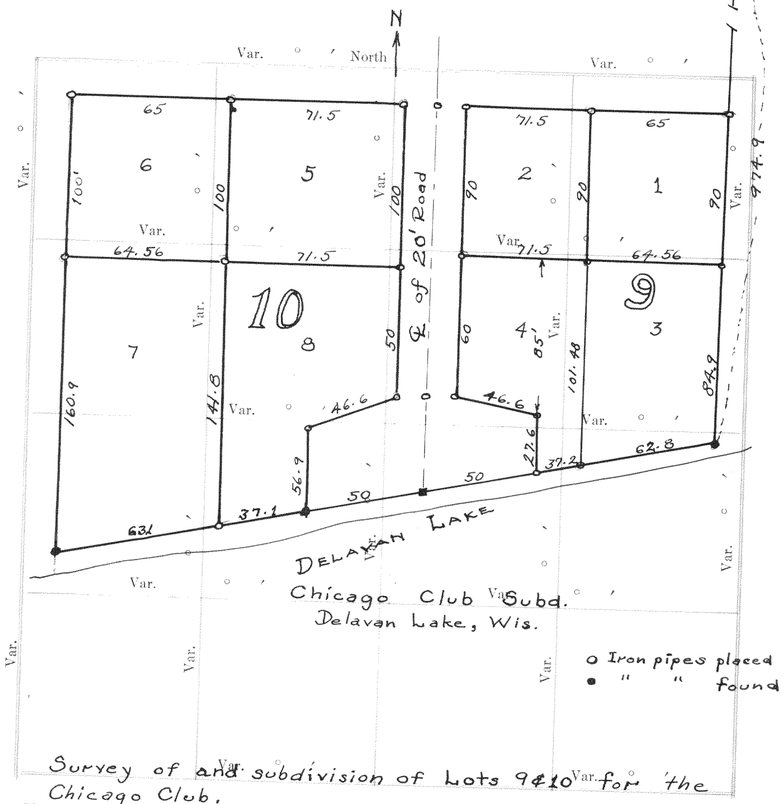

N
Var. ° ' North
NE Cor. of Sec 31 T2N, R16E
Var.
65
71.5
71.5
65
6
5
2
1
100'
100
100
90
90
90
974.9
Var.
64.56
71.5
Var. 71.5
64.56
10
9
7
8
4
3
160.9
141.8
46.6
46.6
50
50
50
101.48
85'
27.6
37.2
62.8
56.9
37.1
631
Var.
Var.
Var.

No. 709

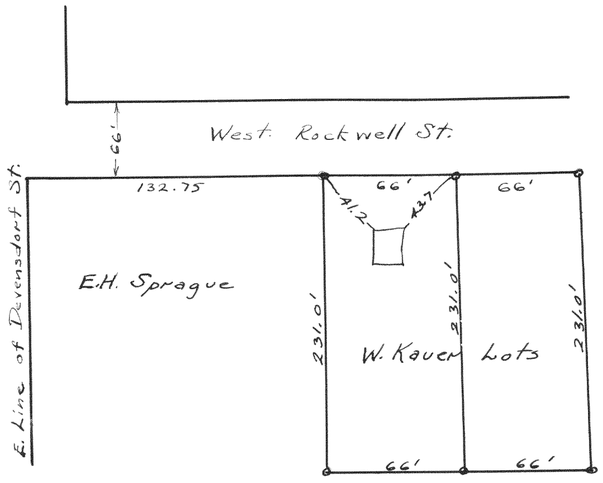

Survey of lots for W. Kauer, Elkhorn, Wis.
April 1, 1936
Lloyd L. Jensen
Co. Surveyor
Recorded by W. E. H.

No. 710

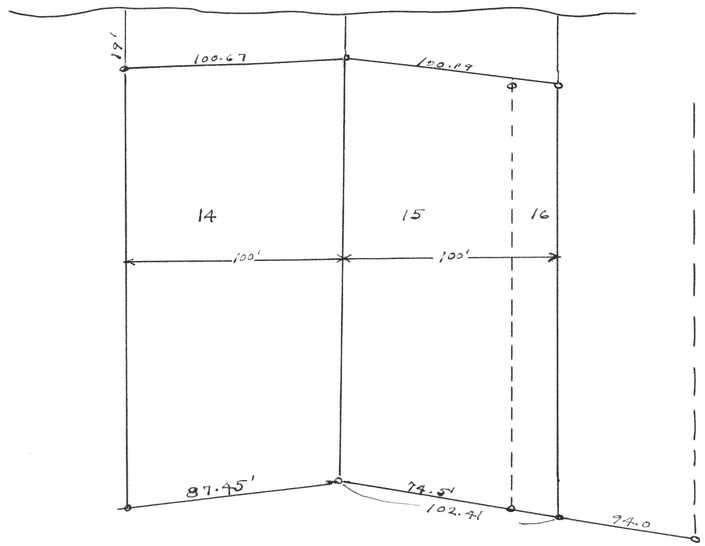

Survey of Lots 14, 15, & part of 16 in
Birches Add (Second) for W. K. Yates.
April 6, 1936
Lloyd L. Jensen
Co. Surveyor
Recorded by W. E. H.