Record of Survey.

Township....., North of Range.....of 4 Principal Meridian as presented by the courses and distances on the following plat, and annexed field-notes of survey:


Established the center of the section at the point of intersection of STRAIGHT quarter lines.

Established all quarter-quarter corners upon the section boundary at proportional distances between known section and quarter section corners, according to the original field-notes of the Government survey.

Established all lost corners at proportionate distances between known corners, according to the original field notes of the Government survey.

No. 719

a #6 are centers of storm sewer manhole covers.

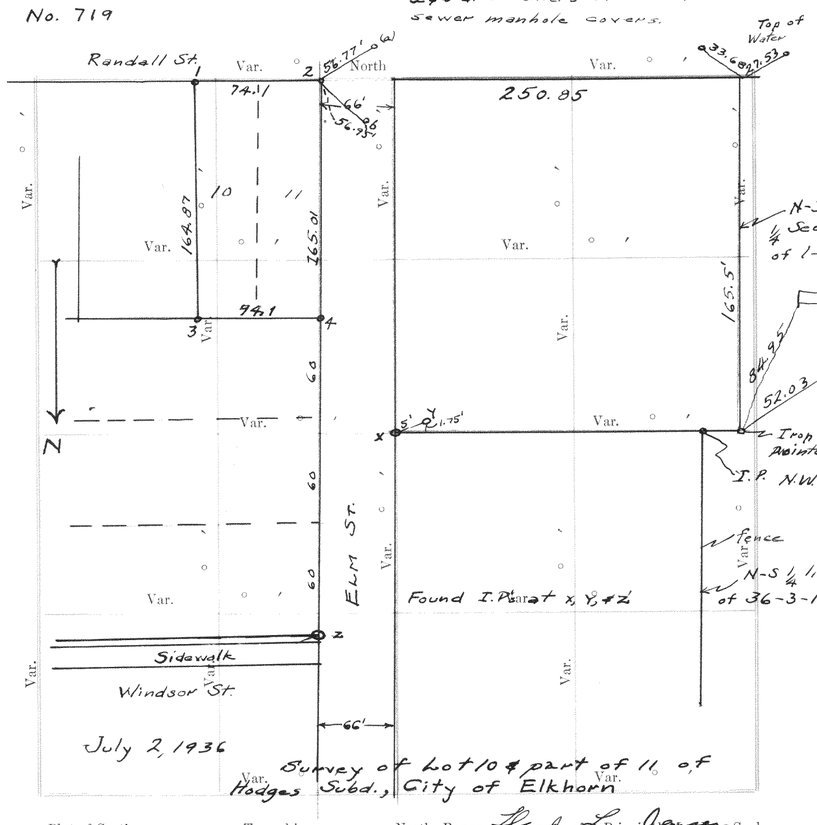

Plat of Section....., Township.....North, Range.....of 4 Principal Meridian Scale 80 chains to 6 inches. The figures in red ink are the lengths of the lines as stated in the field-notes of the Government survey.

Declination of the Magnetic Meridian from the True Meridian.....

Surveyed and sub-divided.....A. D. 1 , in accordance with the State Laws and Instructions of the Commissioner of the General Land office, and recorded on pages .....of Register in the County Clerk's office.

Witness my hand this.....day of.....A. D. 1

.....SURVEYOR.

Lloyd L. Jensen
Co. Surveyor
Recorded by W. E. H.

GOVERNMENT CORNERS

No.
1. N. W. Sec. Cor. indentified,
2. N. E. Sec. Cor. indentified,
3. S. E. Sec. Cor. indentified,
4. S. W. Sec. Cor. indentified,
5. N. ¼ Sec. Cor. indentified,
6. E. ¼ Sec. Cor. indentified,
7. S. ¼ Sec. Cor. indentified,
8. W. ¼ Sec. Cor. indentified,

Subdivision Corners

No.
1. Center ¼ Sec. Cor.
2. North ¼-⅛s N. W. qr.,
3. East ¼-⅛s N. W. qr.,
4. South ¼-⅛s N. W. qr.,
5. West ¼-⅛s N. W. qr.,
6. Center ¼-⅛s N. W. qr.,
7. North ¼-⅛s N. E. qr.,
8. East ¼-⅛s N. E. qr.,
9. South ¼-⅛s N. E. qr.,
10. Center ¼-⅛s N. E. qr.,
11. East ¼-⅛s S. E. qr.,
12. South ¼-⅛s S. E. qr.,
13. West ¼-⅛s S. E. qr.,
14. Center ¼-⅛s S. E. qr.,
15. South ¼-⅛s S. W. qr.,
16. West ¼-⅛s S. W. qr.,
17. Center ¼-⅛s S. W. qr.

CHAINMEN


DESCRIPTION

OF SECTION, QUARTER SECTION AND QUARTER QUARTER SECTION CORNERS

H. C. MILLER CO. MFG. STATIONERS, MILWAUKEE X15000

Bearing Trees	In. Dia.	Courses they bear	Links Distant	Bearing Trees	In. Dia.	Courses they bear	Links Distant	Bearing Trees	In. Dia.	Courses they bear	Links Distant	Bearing Trees	In. Dia.	Courses they bear	Links Distant

No. 720

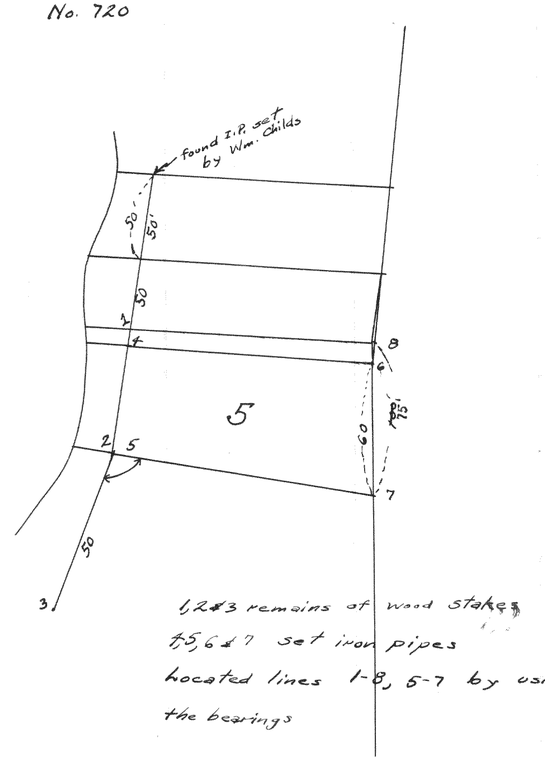

July 3, 1936

Survey of Lot 5 of LaSalva in LaGrange for Mr. Rogers.

Lloyd L. Jensen
Co. Surveyor
Recorded by W. E. H.


NAMES OF SWORN ASSISTANTS

FLAGMEN

AXMEN

231


No. 721

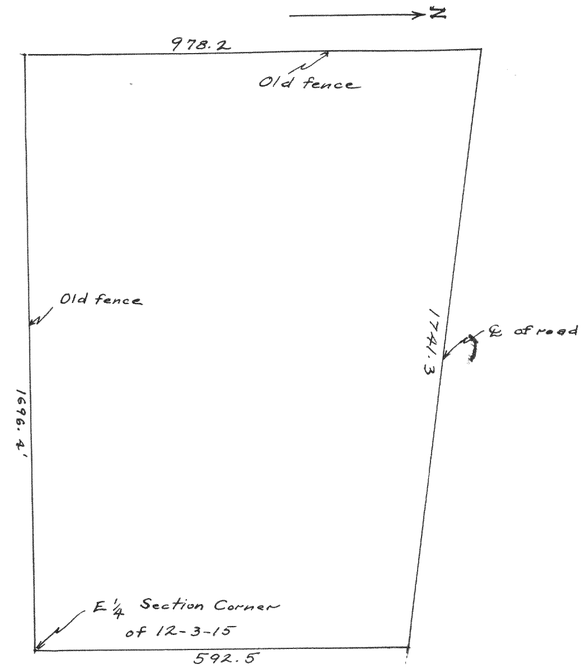

Survey for Walter Topping of
Delavan, Wisconsin.

Lloyd L. Jansen
Co. Surveyor
Recorded by W. L. H.

No. 722

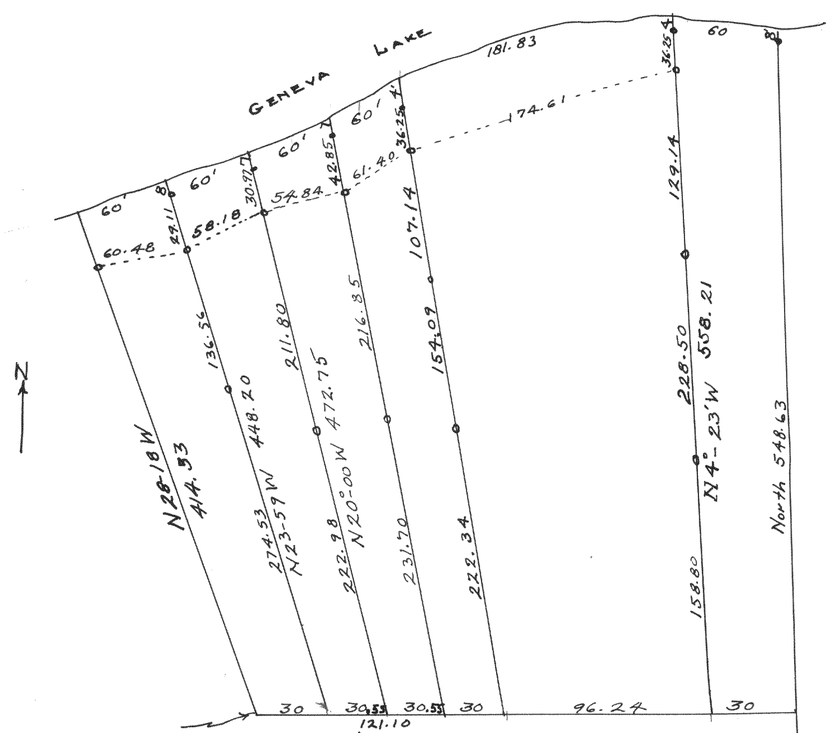

Point 1048.08' North
and 446.10' East of the
West ¼ Sec. cor. of Sec. 12
T1N. R17E Walworth Co. Wis.

Survey of land in 12-1-17, Aug. 25, 1936 for
Wm. Silcock.

Lloyd L. Jansen
Co. Surveyor
Recorded by W. L. H.