
No. 727 **Record of Survey.**

Township....., North of Range.....of 4 Principal Meridian as presented by the courses and distances on the following plat, and annexed field-notes of survey:

Established the center of the section at the point of intersection of STRAIGHT quarter lines.

Established all quarter-quarter corners upon the section boundary at proportional distances between known section and quarter section corners, according to the original field-notes of the Government survey.

Established all lost corners at proportionate distances between known corners, according to the original field notes of the Government survey.

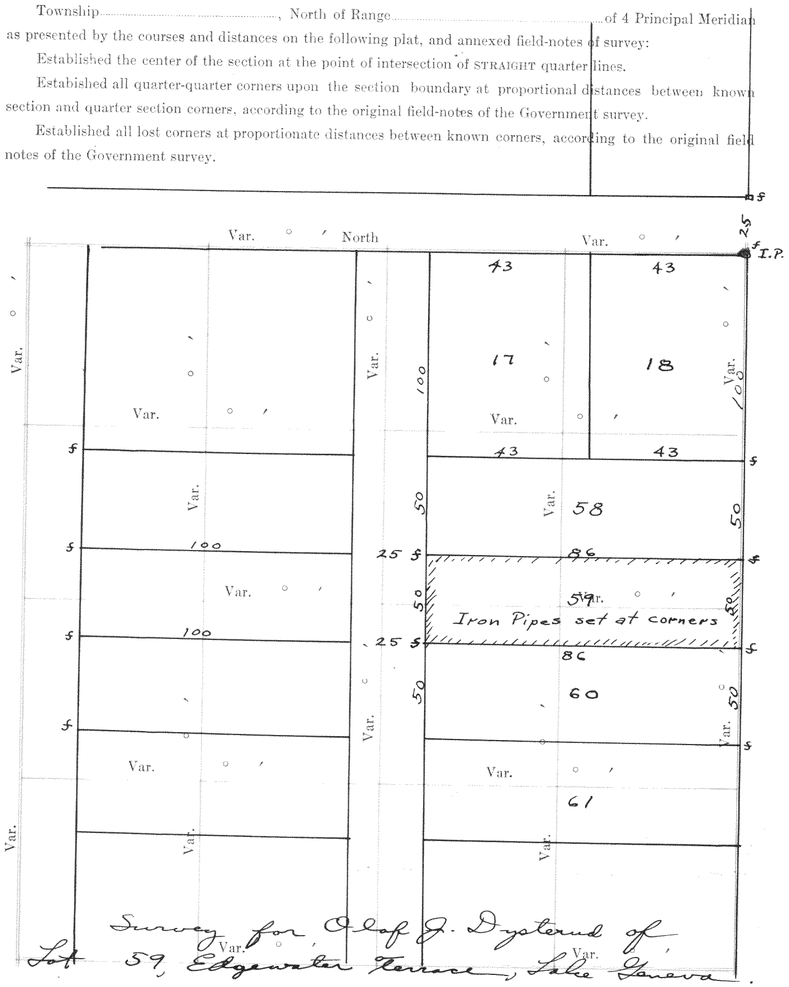

Plat of Section....., Township.....North, Range.....of 4 Principal Meridian Scale 80 chains to 6 inches. The figures in red ink are the lengths of the lines as stated in the field-notes of the Government survey.

Oct. 19 1936

Lloyd L. Jensen
County Surveyor
By W. E. K.

Declination of the Magnetic Meridian from the True Meridian.....

Surveyed and sub-divided.....A. D. 1 , in accordance with the State Laws and Instructions of the Commissioner of the General Land office, and recorded on pages .....of Register in the County Clerk's office.

Witness my hand this.....day of.....A. D. 1

.....SURVEYOR.

DESCRIPTION

OF SECTION, QUARTER SECTION AND QUARTER QUARTER SECTION CORNERS

GOVERNMENT CORNERS

No.
1. N. W. Sec. Cor. indentified,
2. N. E. Sec. Cor. indentified,
3. S. E. Sec. Cor. indentified,
4. S. W. Sec. Cor. indentified,
5. N. ¼ Sec. Cor. indentified,
6. E. ¼ Sec. Cor. indentified,
7. S. ¼ Sec. Cor. indentified,
8. W. ¼ Sec. Cor. indentified,


Subdivision Corners

No.
1. Center ¼ Sec. Cor.
2. North ¼-⅛s N. W. qr.,
3. East ¼-⅛s N. W. qr.,
4. South ¼-⅛s N. W. qr.,
5. West ¼-⅛s N. W. qr.,
6. Center ¼-⅛s N. W. qr.,
7. North ¼-⅛s N. E. qr.,
8. East ¼-⅛s N. E. qr.,
9. South ¼-⅛s N. E. qr.,
10. Center ¼-⅛s N. E. qr.,
11. East ¼-⅛s S. E. qr.,
12. South ¼-⅛s S. E. qr.,
13. West ¼-⅛s S. E. qr.,
14. Center ¼-⅛s S. E. qr.,
15. South ¼-⅛s S. W. qr.,
16. West ¼-⅛s S. W. qr.,
17. Center ¼-⅛s S. W. qr.

Bearing Trees	In. Dia.	Courses they bear	Links Distant

N. C. MILLER CO. MFG. STATIONERS, MILWAUKEE X15000

No. 727a

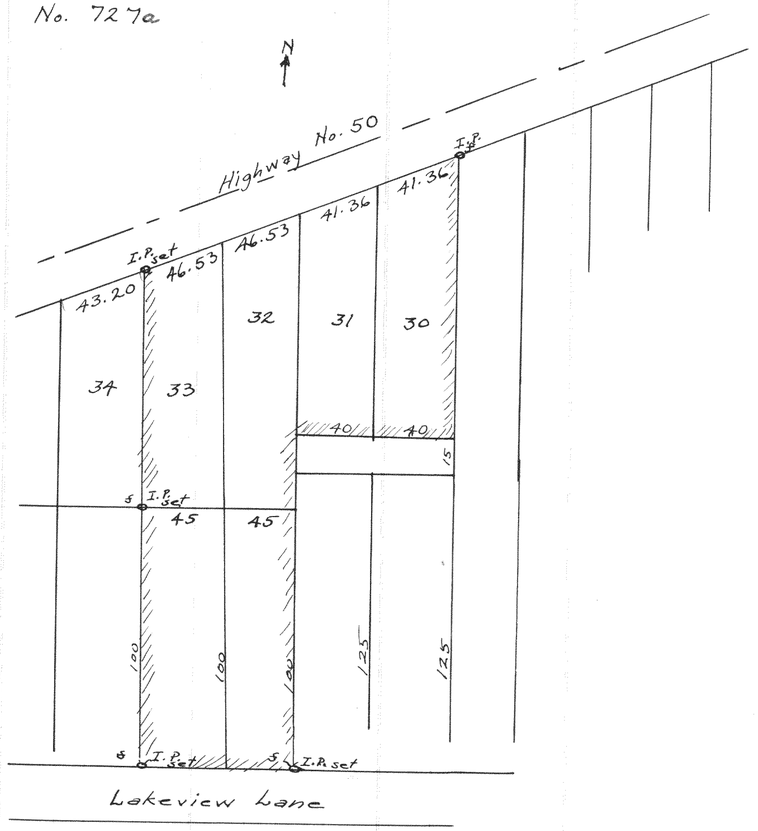

Location of West line of the property of T. Murphy in Lake Geneva Knoll Subdivision, Sec 33-2-17

Oct. 16, 1936


Lloyd L. Jensen
County Surveyor
By W. E. K.

NAMES OF SWORN ASSISTANTS

CHAINMEN

FLAGMEN

No. 728

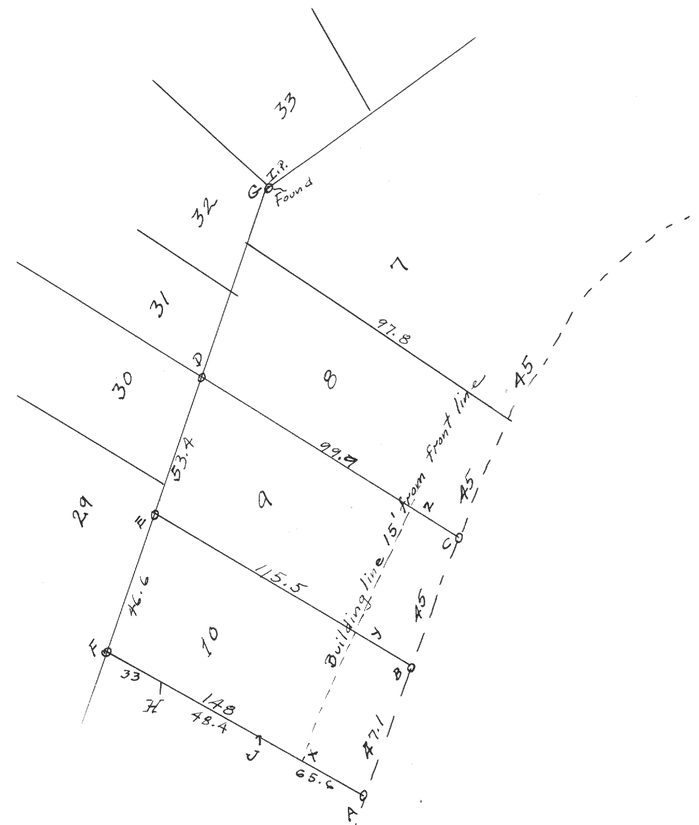


Iron pipes found at F & G
" pins at A, B, C, D, E, H, & J

Survey of lots 9 & 10, block "G"
of Cisco Beach for Major Evans.

Oct. 19, 1936

Lloyd L. Jansen
County Surveyor
By W. E. H.

No. 729

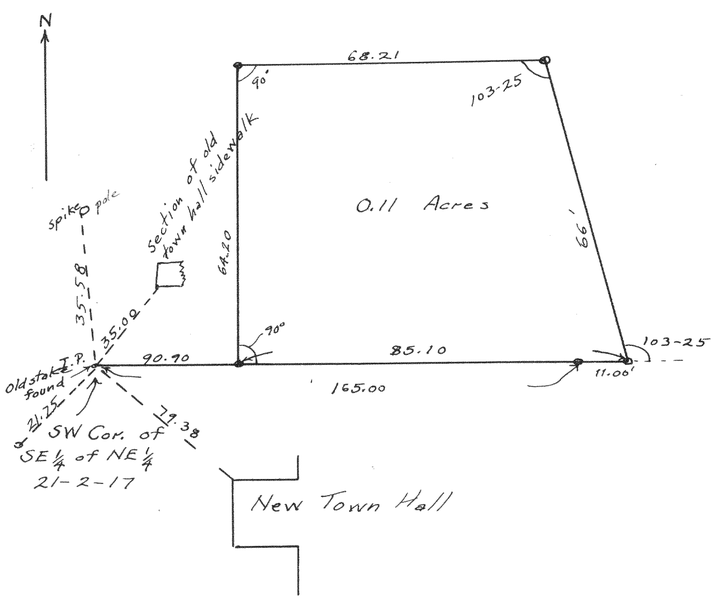

Survey for Town of Geneva.

Lloyd L. Jansen
County Surveyor
By W. E. H.