Record of Survey.


Township....., North of Range.....of 4 Principal Meridian as presented by the courses and distances on the following plat, and annexed field-notes of survey:

Established the center of the section at the point of intersection of STRAIGHT quarter lines.

Established all quarter-quarter corners upon the section boundary at proportional distances between known section and quarter section corners, according to the original field-notes of the Government survey.

Established all lost corners at proportionate distances between known corners, according to the original field notes of the Government survey.

No. 742

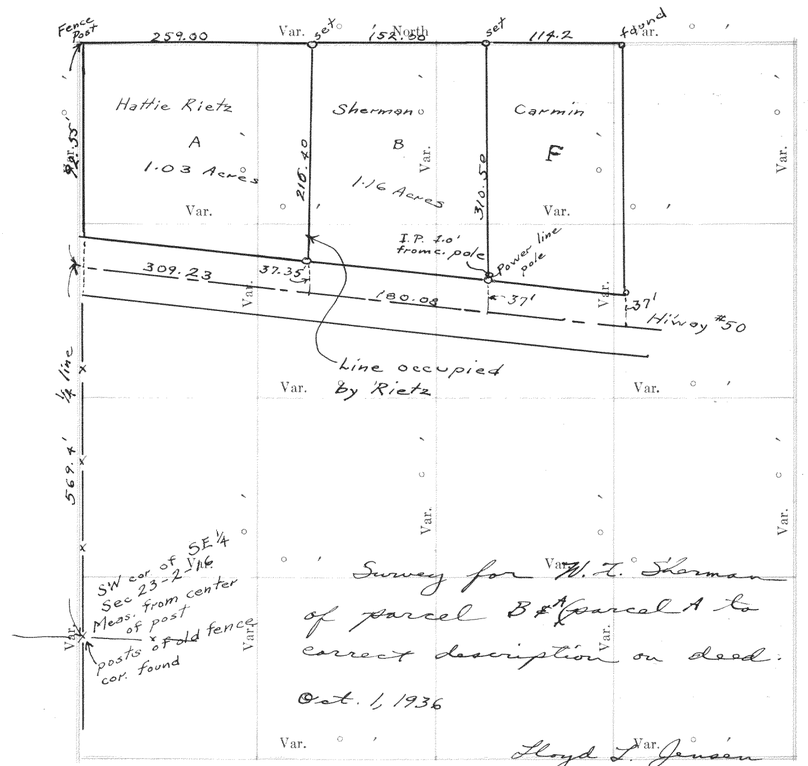

Plat of Section....., Township.....North, Range.....of Principal Meridian Scale 80 chains to 6 inches. The figures in red ink are the lengths of the lines as stated in the field-notes of the Government survey.

Declination of the Magnetic Meridian from the True Meridian.....

Surveyed and sub-divided.....A. D. 1 , in accordance with the State Laws and Instructions of the Commissioner of the General Land office, and recorded on pages .....of Register in the County Clerk's office.

Witness my hand this.....day of.....A. D. 1

.....SURVEYOR.


DESCRIPTION

OF SECTION, QUARTER SECTION AND QUARTER QUARTER SECTION CORNERS

H. C. MILLER CO., MFG. STATIONERS, MILWAUKEE X15000

GOVERNMENT CORNERS	Bearing Trees	In. Dia.	Courses they bear	Links Distant	Bearing Trees	In. Dia.	Courses they bear	Links Distant	Bearing Trees	In. Dia.	Courses they bear	Links Distant	Bearing Trees	In. Dia.	Courses they bear	Links Distant
No.																
1. N. W. Sec. Cor. indentified,																
2. N. E. Sec. Cor. indentified,																
3. S. E. Sec. Cor. indentified,																
4. S. W. Sec. Cor. indentified,																
5. N. 1/4 Sec. Cor. indentified,																
6. E. 1/4 Sec. Cor. indentified,																
7. S. 1/4 Sec. Cor. indentified,																
8. W. 1/4 Sec. Cor. indentified,																
Subdivision Corners																
No.																
1. Center 1/4 Sec. Cor.																
2. North 1/4-1/8 s N. W. qr.,																
3. East 1/4-1/8 s N. W. qr.,																
4. South 1/4-1/8 s N. W. qr.,																
5. West 1/4-1/8 s N. W. qr.,																
6. Center 1/4-1/8 s N. W. qr.,																
7. North 1/4-1/8 s N. E. qr.,																
8. East 1/4-1/8 s N. E. qr.,																
9. South 1/4-1/8 s N. E. qr.,																
10. Center 1/4-1/8 s N. E. qr.,																
11. East 1/4-1/8 s S. E. qr.,																
12. South 1/4-1/8 s S. E. qr.,																
13. West 1/4-1/8 s S. E. qr.,																
14. Center 1/4-1/8 s S. E. qr.,																
15. South 1/4-1/8 s S. W. qr.,																
16. West 1/4-1/8 s S. W. qr.,																
17. Center 1/4-1/8 s S. W. qr.																

No. 743

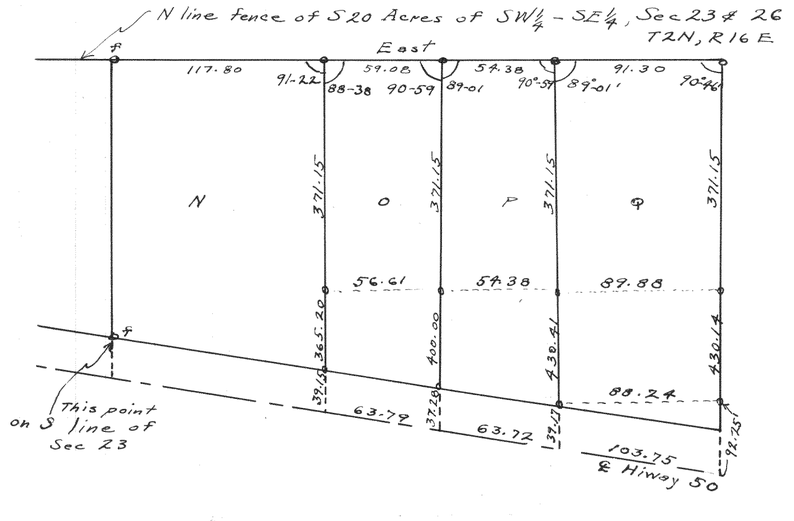

Survey of parcels O, P, & Q for W. T. Sherman of East Delavan

Oct. 4, 1936

Nov. "


Floyd L. Jensen
County Surveyor
By W. C. H.

NAMES OF SWORN ASSISTANTS

CHAINMEN	FLAGMEN	AXMEN

237

No. 744

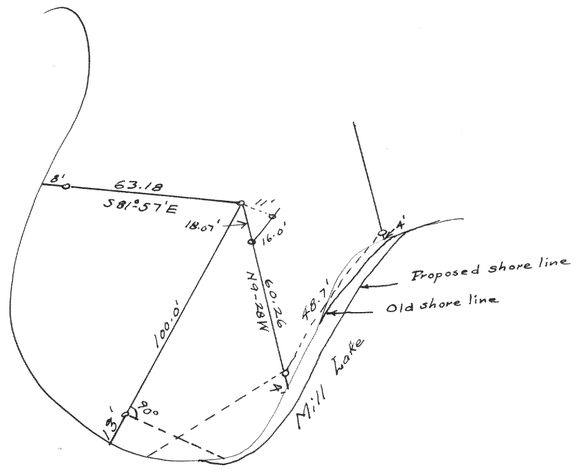


Lauderdale Lakes

NW¼ Sec 36- 4-16

Location of shoreline
for W. J. Seymour.
Oct. 1936

Lloyd L. Jensen

No. 745

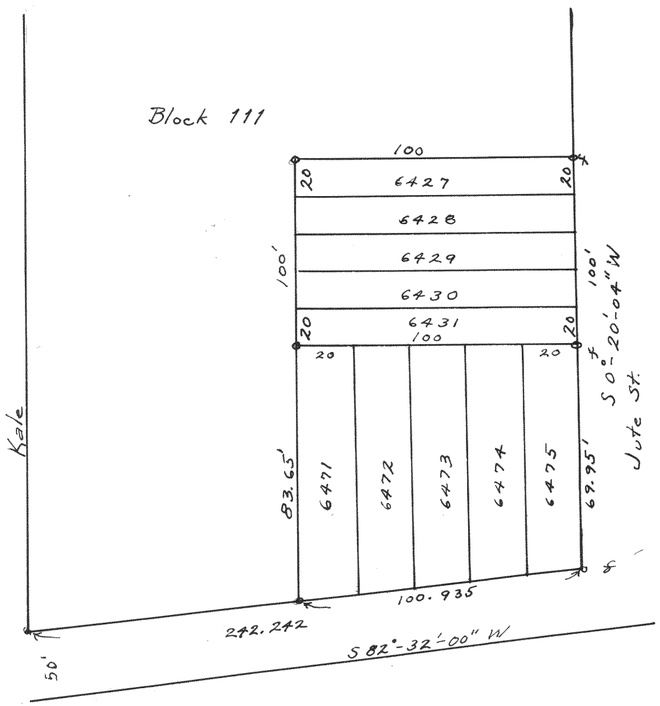

Survey for Mrs. Emma Antonsen
at Lake Como.

Oct. 1936

Lloyd L. Jensen
County Surveyor
By W. E. H.