Record of Survey.


No 55 Survey on South Shore of Booth Lake

Township ..... North of Range ..... of 4 Principal Meridian as presented by the courses and distances on the following plat, and annexed field-notes of survey:

Established the center of the section at the point of intersection of STRAIGHT quarter lines.

Established all quarter-quarter corners upon the section boundary at proportional distances between known section and quarter section corners, according to the original field-notes of the Government survey.

Established all lost corners at proportionate distances between known corners, according to the original field notes of the Government survey.

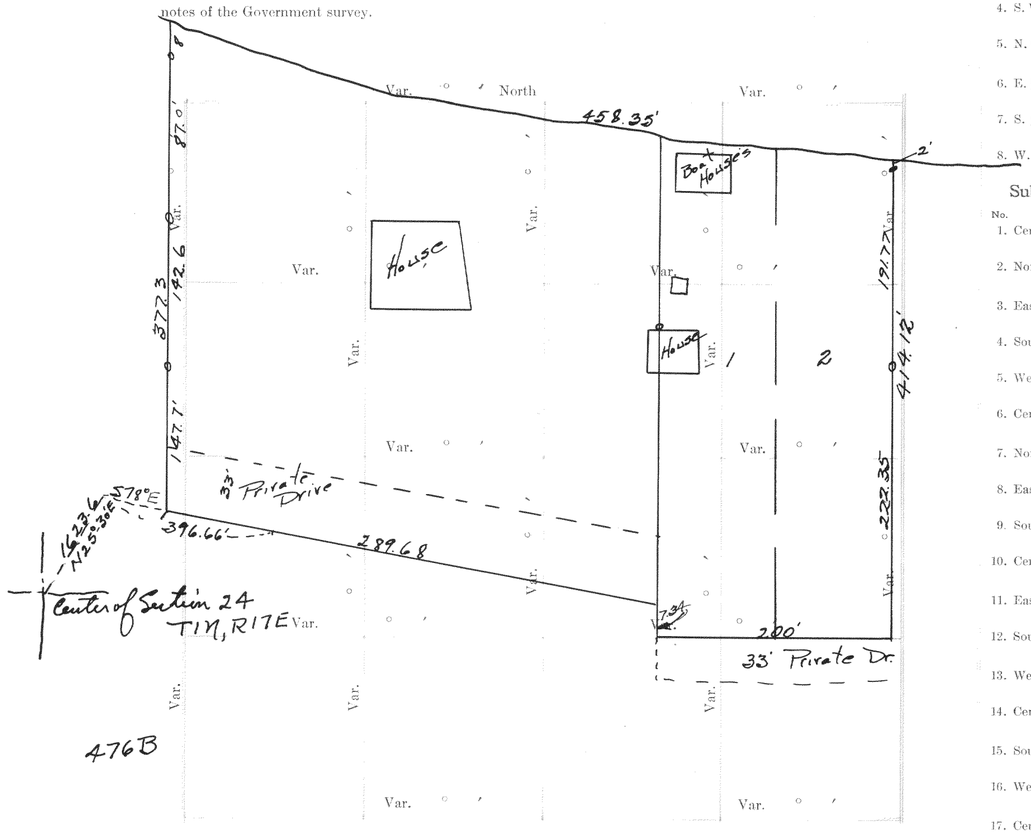

Plat of Section ....., Township ..... North, Range ..... of 4 Principal Meridian Scale 80 chains to 6 inches. The figures in red ink are the lengths of the lines as stated in the field-notes of the Government survey.

Declination of the Magnetic Meridian from the True Meridian .....

Surveyed and sub-divided ..... A. D. 1 , in accordance with the State Laws and Instructions of the Commissioner of the General Land office, and recorded on pages ..... of Register in the County Clerk's office.

Witness my hand this ..... day of ..... A. D. 1

..... SURVEYOR.

DESCRIPTION

OF SECTION, QUARTER SECTION AND QUARTER QUARTER SECTION CORNERS

GOVERNMENT CORNERS

No.	Bearing Trees	In. Dia.	Courses they bear	Links Distant	Bearing Trees	In. Dia.	Courses they bear	Links Distant	Bearing Trees	In. Dia.	Courses they bear	Links Distant	Bearing Trees	In. Dia.	Courses they bear	Links Distant
1. N. W. Sec. Cor. indentified,																
2. N. E. Sec. Cor. indentified,																
3. S. E. Sec. Cor. indentified,																
4. S. W. Sec. Cor. indentified,																
5. N. ¼ Sec. Cor. indentified,																
6. E. ¼ Sec. Cor. indentified,																
7. S. ¼ Sec. Cor. indentified,																
8. W. ¼ Sec. Cor. indentified,																

Subdivision Corners

No.
1. Center ¼ Sec. Cor.
2. North ¼-⅛s N. W. qr.,
3. East ¼-⅛s N. W. qr.,
4. South ¼-⅛s N. W. qr.,
5. West ¼-⅛s N. W. qr.,
6. Center ¼-⅛s N. W. qr.,
7. North ¼-⅛s N. E. qr.,
8. East ¼-⅛s N. E. qr.,
9. South ¼-⅛s N. E. qr.,
10. Center ¼-⅛s N. E. qr.,
11. East ¼-⅛s S. E. qr.,
12. South ¼-⅛s S. E. qr.,
13. West ¼-⅛s S. E. qr.,
14. Center ¼-⅛s S. E. qr.,
15. South ¼-⅛s S. W. qr.,
16. West ¼-⅛s S. W. qr.,
17. Center ¼-⅛s S. W. qr.

N. C. MILLER CO., MFG. STATIONERS, MILWAUKEE X15000

I hereby certify that on the 28th day of Aug. 1933 I completed a survey of land as shown on survey plat 476B, the description of which is as follows

Parcel no I, Commencing at the center of Section 24, T4N, R17E thence N25°-30'E 1623.6 feet; thence S78°-00'E 341.66 feet to the place of beginning; thence S78°-00'E 289.68' to a point 7.34 feet north of the S.W. Cor. of lot I of Hultquists Subd. as recorded in and for Wal. Co. Wis. thence N. on the W. line of said lot I to the shore of Booth Lake; thence northeasterly along the shore of Booth Lake 258.35' to a pt. thence southerly 377.3' to the place of beginning


Parcel no II Lots I & II of Hultquists Subd. as recorded in and for for Walworth Co. Wisconsin

Lloyd S. Jensen
County Surveyor

NAMES OF SWORN ASSISTANTS

CHAINMEN	FLAGMEN	AXMEN

No 56

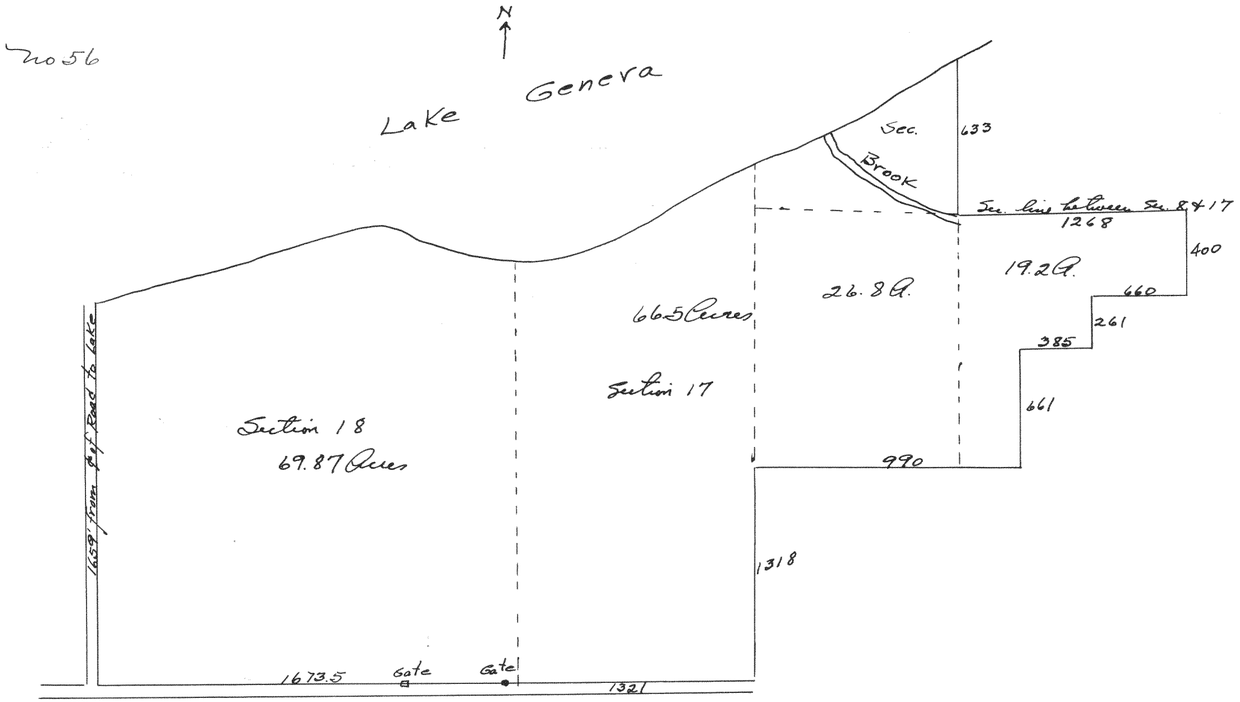

Plat of Land

Surveyed for the Arthur Kay Estate on Sections 8, 17 & 18 in T1N, R17E in Town of Linn, Walworth County, Wis. This plat is a correct representation of said plat of land as fenced, & said plat contains 182.4 Acres. The lengths of the lines is given in feet. The center of the road as fenced was taken as the line of plat.

Scale 200' = 1"

Wm Child,
County Surveyor
Walworth Co., Wisconsin

Elkhorn, June 28, 1902