Record of Survey.


Township....., North of Range.....of 4 Principal Meridian as presented by the courses and distances on the following plat, and annexed field-notes of survey:

Established the center of the section at the point of intersection of STRAIGHT quarter lines.

Established all quarter-quarter corners upon the section boundary at proportional distances between known section and quarter section corners, according to the original field-notes of the Government survey.

Established all lost corners at proportionate distances between known corners, according to the original field notes of the Government survey.

No. 764

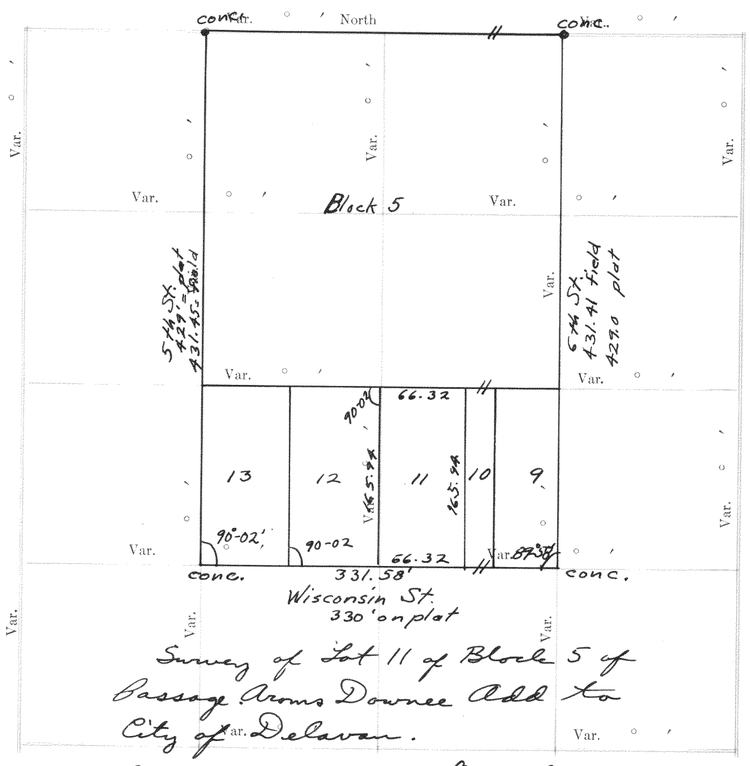

Survey of Lot 11 of Block 5 of Cassage Arms Downee Add to City of Delavan.

Plat of Section Aug. 20, 1936 Township North, Range Lloyd L. Jensen of the 4th Principal Meridian Scale 80 chains to 6 inches. The figures in red ink are the lengths ~~of lines as stated in the field notes~~ of the Government survey. County Engr. By W. E. H.

Declination of the Magnetic Meridian from the True Meridian.....

Surveyed and sub-divided.....A. D. 1 , in accordance with the State Laws and Instructions of the Commissioner of the General Land office, and recorded on pages .....of Register in the County Clerk's office.

Witness my hand this.....day of.....A. D. 1

.....SURVEYOR.

DESCRIPTION


OF SECTION, QUARTER SECTION AND QUARTER QUARTER SECTION CORNERS

243

N. C. MILLER CO., MFG. STATIONERS, MILWAUKEE X15000

GOVERNMENT CORNERS	Bearing Trees	In. Dia.	Courses they bear	Links Distant	Bearing Trees	In. Dia.	Courses they bear	Links Distant	Bearing Trees	In. Dia.	Courses they bear	Links Distant	Bearing Trees	In. Dia.	Courses they bear	Links Distant
No.																
1. N. W. Sec. Cor. indentified,																
2. N. E. Sec. Cor. indentified,																
3. S. E. Sec. Cor. indentified,																
4. S. W. Sec. Cor. indentified,																
5. N. ¼ Sec. Cor. indentified,																
6. E. ¼ Sec. Cor. indentified,																
7. S. ¼ Sec. Cor. indentified,																
8. W. ¼ Sec. Cor. indentified,																
Subdivision Corners																
No.																
1. Center ¼ Sec. Cor.																
2. North ¼-¼s N. W. qr.,																
3. East ¼-¼s N. W. qr.,																
4. South ¼-¼s N. W. qr.,																
5. West ¼-¼s N. W. qr.,																
6. Center ¼-¼s N. W. qr.,																
7. North ¼-¼s N. E. qr.,																
8. East ¼-¼s N. E. qr.,																
9. South ¼-¼s N. E. qr.,																
10. Center ¼-¼s N. E. qr.,																
11. East ¼-¼s S. E. qr.,																
12. South ¼-¼s S. E. qr.,																
13. West ¼-¼s S. E. qr.,																
14. Center ¼-¼s S. E. qr.,																
15. South ¼-¼s S. W. qr.,																
16. West ¼-¼s S. W. qr.,																
17. Center ¼-¼s S. W. qr.																

No. 765

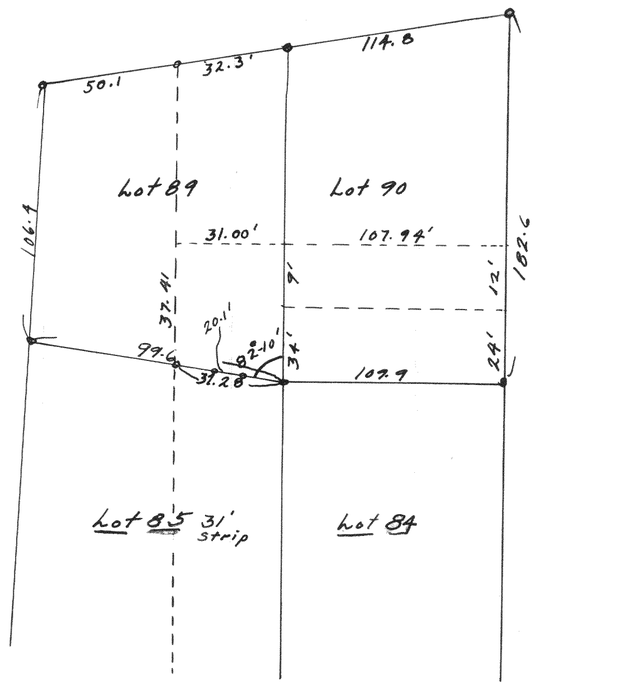

Subdivision of Lots as shown in Country Club Estates Unit 2.

Aug. 31, 1936

Lloyd L. Jensen
County Surveyor
By W. E. H.

CHAINMEN


NAMES OF SWORN ASSISTANTS

FLAGMEN

AXMEN

243


No. 766

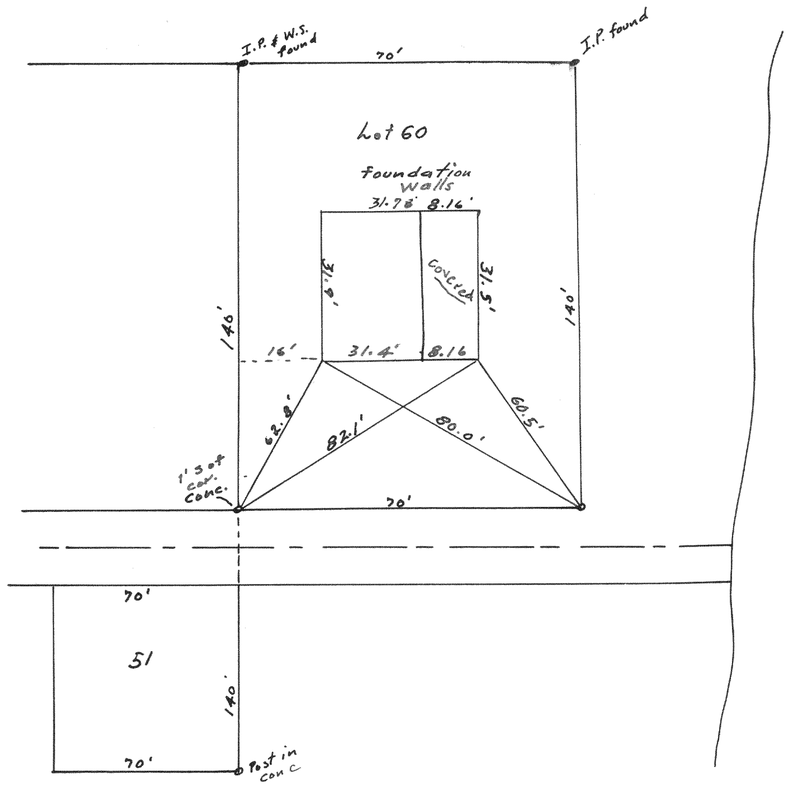

Lot 60 of Lackey Bros Subd.
in Wms. Bay. for O. A. Rosboro
1450 Railway Exchange, Chicago, Ill.

Lloyd L. Jensen
County Surveyor
By W. E. H.

No. 767

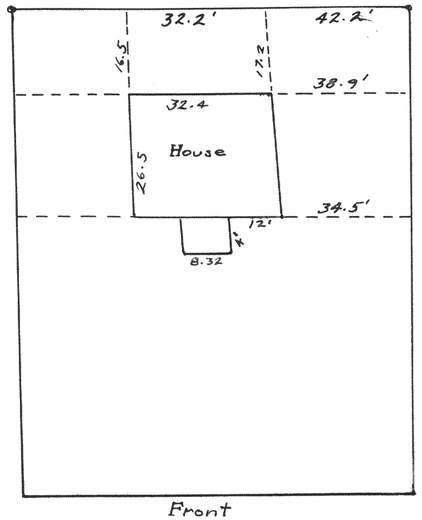

Location of house on Lot 19 of Block D
Country Club Estates (Unit 3).

Sept. 2, 1936

Lloyd L. Jensen
County Surveyor
By W. E. H.