
247

No. 778

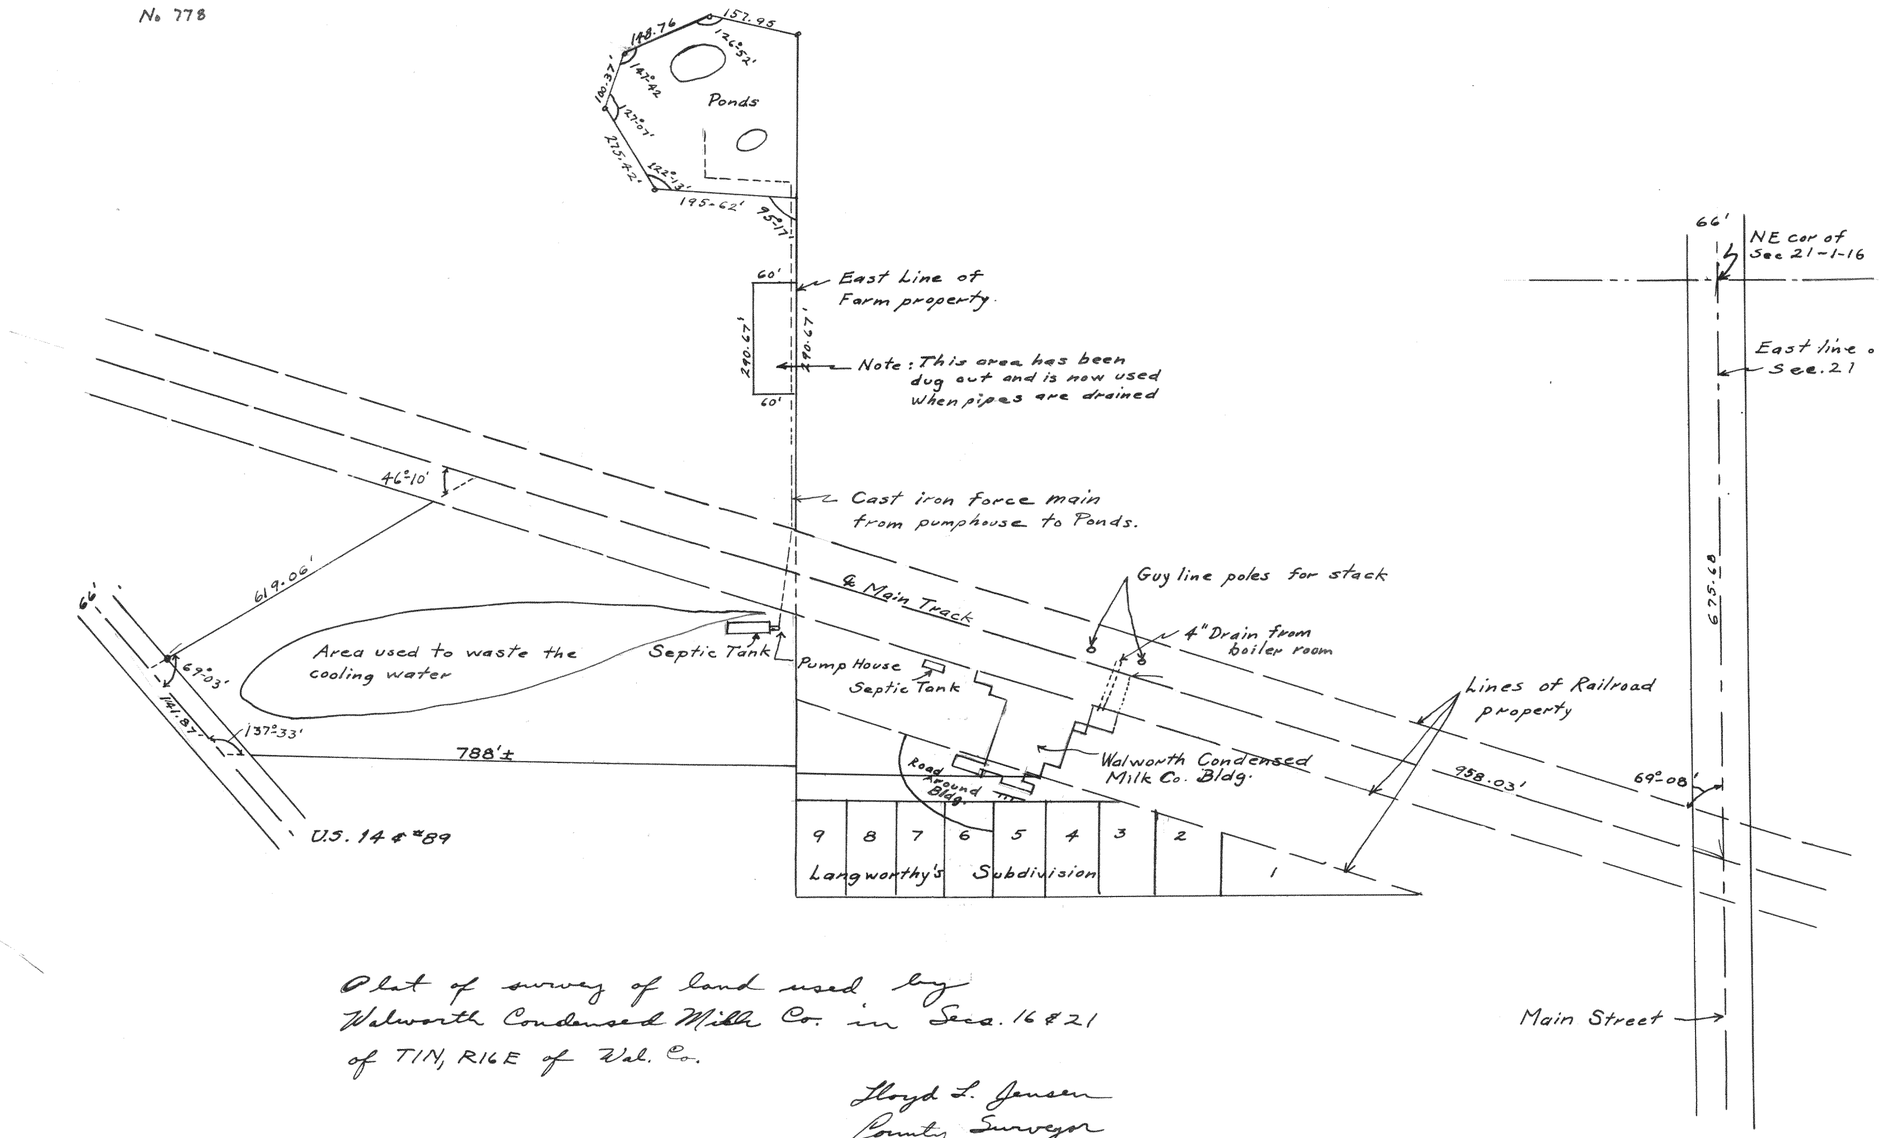

Plat of survey of land used by Walworth Condensed Milk Co. in Secs. 16 & 21 of T1N, R1E of Wal. Co.

Lloyd L. Jensen
County Surveyor
By M. E. H.

Record of Survey.


Township....., North of Range.....of 4 Principal Meridian as presented by the courses and distances on the following plat, and annexed field-notes of survey:

Established the center of the section at the point of intersection of STRAIGHT quarter lines.

Estabished all quarter-quarter corners upon the section boundary at proportional distances between known section and quarter section corners, according to the original field-notes of the Government survey.

Established all lost corners at proportionate distances between known corners, according to the original field notes of the Government survey.

No. 774

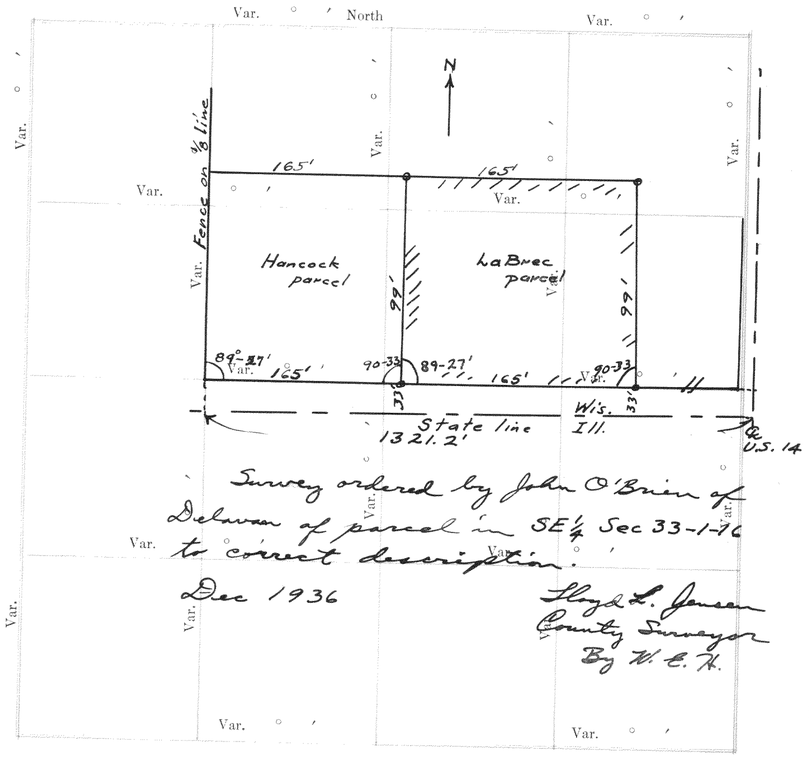

Plat of Section....., Township.....North, Range.....of 4 Principal Meridian Scale 80 chains to 6 inches. The figures in red ink are the lengths of the lines as stated in the field-notes of the Government survey.

Declination of the Magnetic Meridian from the True Meridian.....

Surveyed and sub-divided.....A. D. 1 , in accordance with the State Laws and Instructions of the Commissioner of the General Land office, and recorded on pages .....of Register in the County Clerk's office.

Witness my hand this.....day of.....A. D. 1

.....SURVEYOR.


DESCRIPTION

OF SECTION, QUARTER SECTION AND QUARTER QUARTER SECTION CORNERS

247

H. C. MILLER CO., MFG. STATIONERS, MILWAUKEE X15000

GOVERNMENT CORNERS	Bearing Trees	In. Dia.	Courses they bear	Links Distant	Bearing Trees	In. Dia.	Courses they bear	Links Distant	Bearing Trees	In. Dia.	Courses they bear	Links Distant	Bearing Trees	In. Dia.	Courses they bear	Links Distant
No.																
1. N. W. Sec. Cor. indentified,	No. 780															
2. N. E. Sec. Cor. indentified,																
3. S. E. Sec. Cor. indentified,																
4. S. W. Sec. Cor. indentified,																
5. N. ¼ Sec. Cor. indentified,																
6. E. ¼ Sec. Cor. indentified,																
7. S. ¼ Sec. Cor. indentified,																
8. W. ¼ Sec. Cor. indentified,																
Subdivision Corners																
No.																
1. Center ¼ Sec. Cor.																
2. North ¼-⅛s N. W. qr.,																
3. East ¼-⅛s N. W. qr.,																
4. South ¼-⅛s N. W. qr.,																
5. West ¼-⅛s N. W. qr.,																
6. Center ¼-⅛s N. W. qr.,																
7. North ¼-⅛s N. E. qr.,																
8. East ¼-⅛s N. E. qr.,																
9. South ¼-⅛s N. E. qr.,																
10. Center ¼-⅛s N. E. qr.,																
11. East ¼-⅛s S. E. qr.,																
12. South ¼-⅛s S. E. qr.,																
13. West ¼-⅛s S. E. qr.,																
14. Center ¼-⅛s S. E. qr.,																
15. South ¼-⅛s S. W. qr.,																
16. West ¼-⅛s S. W. qr.,																
17. Center ¼-⅛s S. W. qr.																

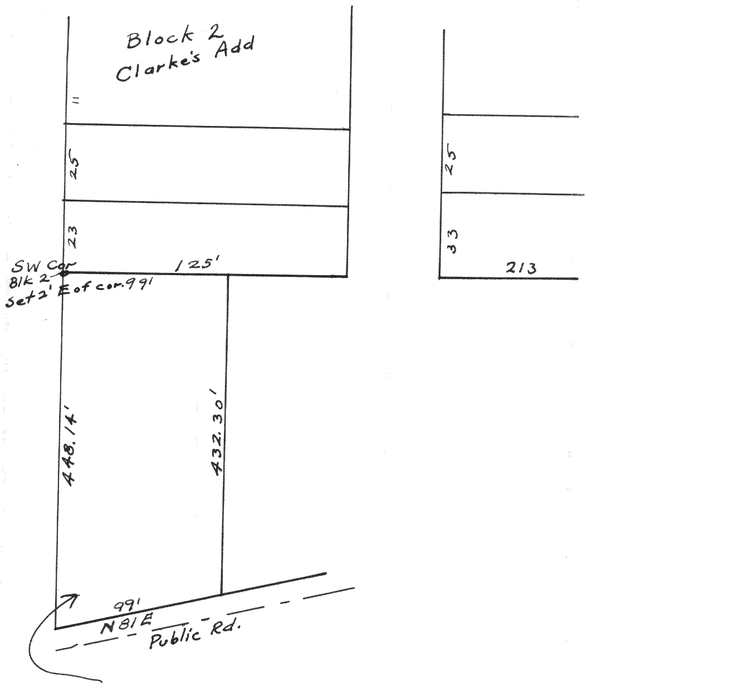


Survey of parcel for E. G. Brown of East Troy in Sec 19 T 30 - 4 - 18.

Lloyd L. Jensen
County Surveyor
By W. E. H.

NAMES OF SWORN ASSISTANTS

CHAINMEN	FLAGMEN	AXMEN


No. 781

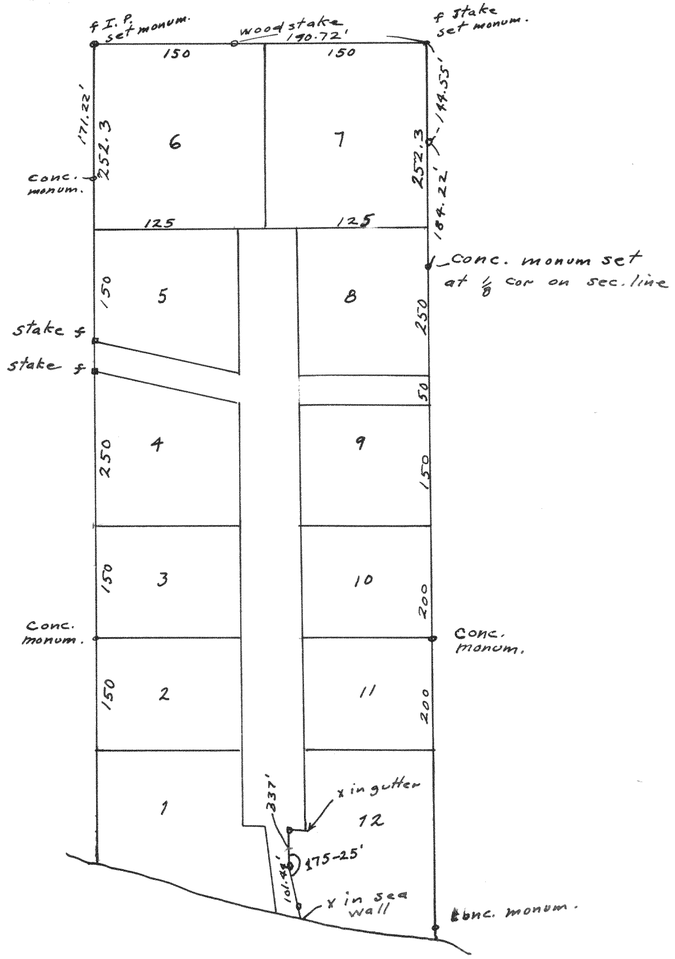

Survey of lots 3-12 of Sylvan Trail Estates for A. W. Herbst in Sec 5-1-17.

Lloyd L. Jensen
County Surveyor
By W. E. H.

No. 782

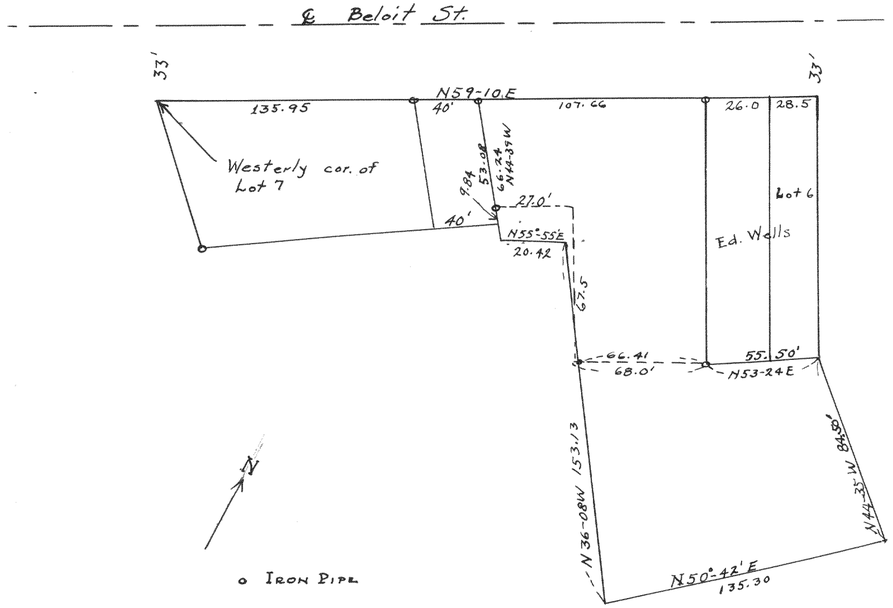

Plat of a survey of land in the 4th Addition to Darien located in Section 27, T2N, R15E.
Sept. 1936

Lloyd L. Jensen
County Surveyor
By W. E. H.