Record of Survey.


No. 57

Township....., North of Range.....of 4 Principal Meridian as presented by the courses and distances on the following plat, and annexed field-notes of survey:

Established the center of the section at the point of intersection of STRAIGHT quarter lines.

Estabished all quarter-quarter corners upon the section boundary at proportional distances between known section and quarter section corners, according to the original field-notes of the Government survey.

Established all lost corners at proportionate distances between known corners, according to the original field notes of the Government survey.

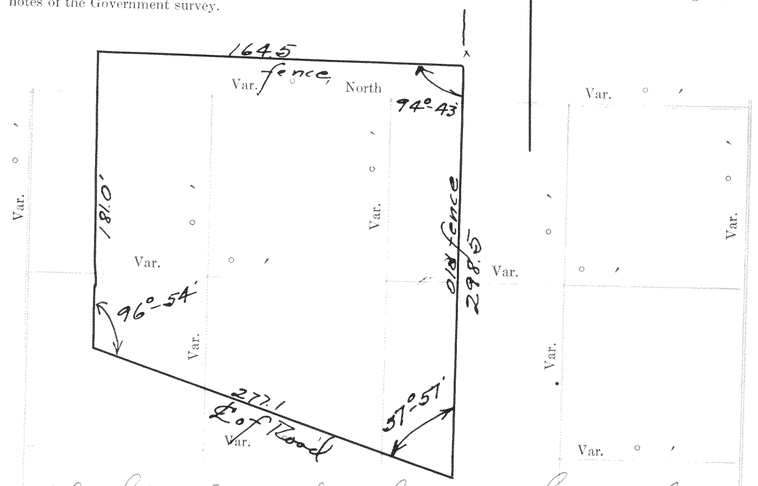

All that certain part of the E½ of the SW¼ of Sec. 23 T2N, R17E. - Beginning at a pt. in the center of the highway leading from Delavan to E. L. where the same crosses the N. & S. ¼ Sec. Cor. of Sec. 23 running thence N. on said ¼ Sec. line 18 rds. thence W 10 rds, thence S 10 rds & 14' to the center of said road, thence Southeasterly along the ℄ of said road 16 rds & 10' to the place of beginning. The above is the description of Jensen Kahlberg's land & the drawing shows the measurements as taken in the field. No stakes were driven.

Floyd V. Jensen County Surveyor.
June 19, 1933

Plat of Section....., Township.....North, Range.....of 4 Principal Meridian Scale 80 chains to 6 inches. The figures in red ink are the lengths of the lines as stated in the field-notes of the Government survey.

Declination of the Magnetic Meridian from the True Meridian.....

Surveyed and sub-divided.....A. D. 1 , in accordance with the State Laws and Instructions of the Commissioner of the General Land office, and recorded on pages .....of Register in the County Clerk's office.

Witness my hand this.....day of.....A. D. 1

.....SURVEYOR.

DESCRIPTION

No. 58 OF SECTION, QUARTER SECTION AND QUARTER QUARTER SECTION CORNERS

GOVERNMENT CORNERS


No.
1. N. W. Sec. Cor. indentified,
2. N. E. Sec. Cor. indentified,
3. S. E. Sec. Cor. indentified,
4. S. W. Sec. Cor. indentified,
5. N. ¼ Sec. Cor. indentified,
6. E. ¼ Sec. Cor. indentified,
7. S. ¼ Sec. Cor. indentified,
8. W. ¼ Sec. Cor. indentified,

Subdivision Corners

No.
1. Center ¼ Sec. Cor.
2. North ¼-¼s N. W. qr.,
3. East ¼-¼s N. W. qr.,
4. South ¼-¼s N. W. qr.,
5. West ¼-¼s N. W. qr.,
6. Center ¼-¼s N. W. qr.,
7. North ¼-¼s N. E. qr.,
8. East ¼-¼s N. E. qr.,
9. South ¼-¼s N. E. qr.,
10. Center ¼-¼s N. E. qr.,
11. East ¼-¼s S. E. qr.,
12. South ¼-¼s S. E. qr.,
13. West ¼-¼s S. E. qr.,
14. Center ¼-¼s S. E. qr.,
15. South ¼-¼s S. W. qr.,
16. West ¼-¼s S. W. qr.,
17. Center ¼-¼s S. W. qr.

Bearing Trees	In. Dia.	Courses they bear	Links Distant	Bearing Trees	In. Dia.	Courses they bear	Links Distant	Bearing Trees	In. Lia.	Courses they bear	Links Distant	Bearing Trees	In. Dia.	Courses they bear	Links Distant

N. C. MILLER CO., MFG. STATIONERS, MILWAUKEE X15000

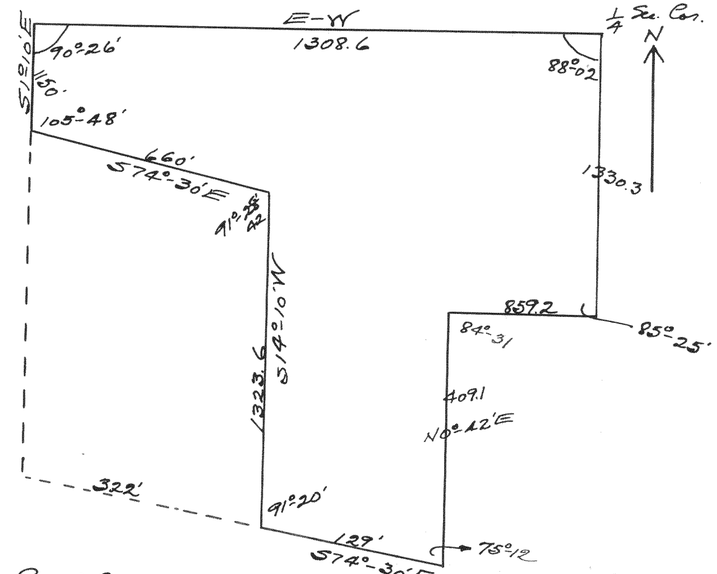

Location E½ NW¼ of 13-2-15


Survey of a portion of the Barker farm. Fences were used as the lines and the description written as shown on the drawing.

Floyd V. Jensen
July 16, 1933 County Surveyor


NAMES OF SWORN ASSISTANTS

CHAINMEN | FLAGMEN | AXMEN

No 59 Lime Kiln Park
South Shore
Geneva Lake

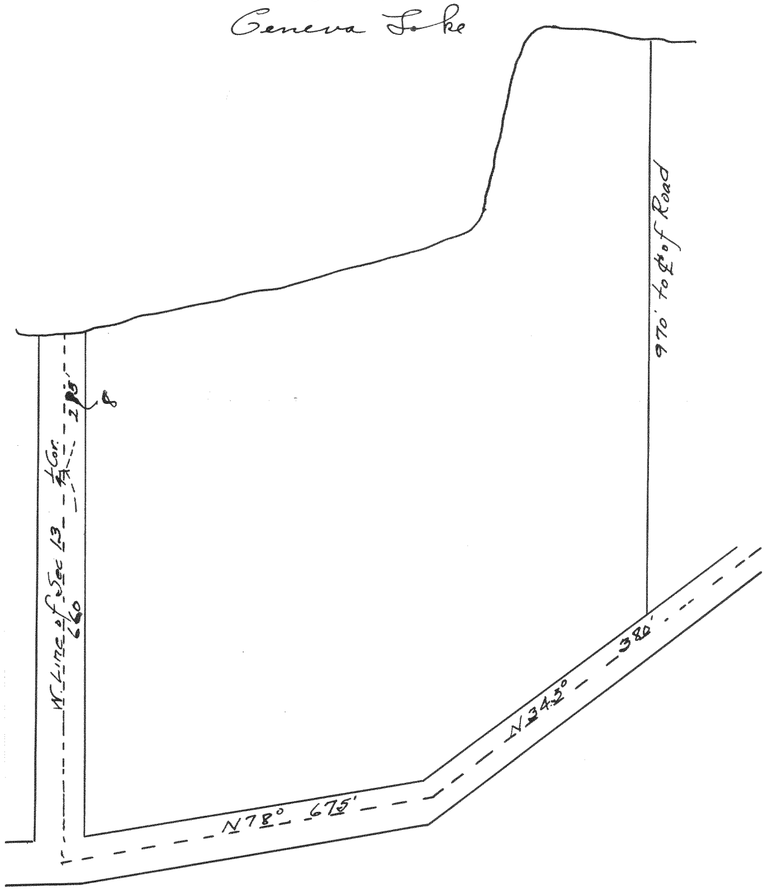

No 60

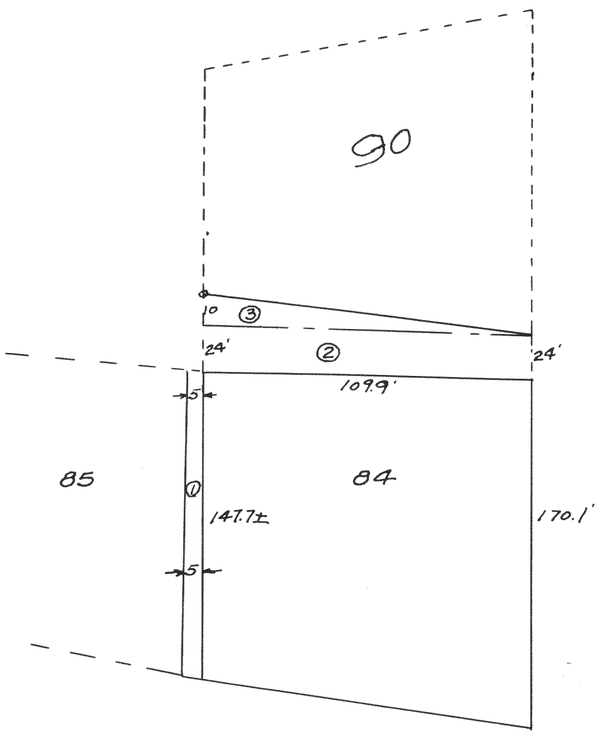

Property of I.C. Stickles
Lot 84
Parcels ① a 5' strip off from the South side of lot 85
" ② @ 24' " " " " E. end of " 90
" ③ " strip of land in lot 90, 10' wide at the S. end and 20' wide at the N. end & joins the strip of land designated as parcel #2.
All in Unit No. 2 of County Club Estates.
Fontana, Wisconsin
Floyd S. Jensen
County Surveyor