
Record of Survey.

Township No. 787, North of Range ..... of 4 Principal Meridian as presented by the courses and distances on the following plat, and annexed field-notes of survey:

Established the center of the section at the point of intersection of STRAIGHT quarter lines.

Established all quarter-quarter corners upon the section boundary at proportional distances between known section and quarter section corners, according to the original field-notes of the Government survey.

Established all lost corners at proportionate distances between known corners, according to the original field notes of the Government survey.

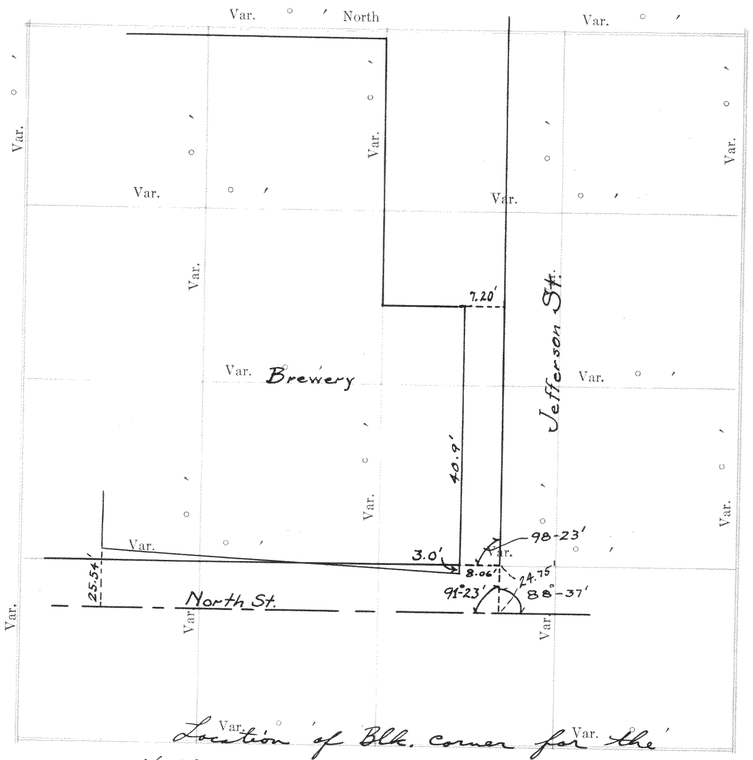

Plat of Section Whitewater Township Brewery North Range the City of 4 Principal Meridian Scale 80 chains to 6 inches. The figures in red ink are the lengths of the lines as stated in the field-notes of the Government survey.

Declination of the Magnetic Meridian from the True Meridian .....

Surveyed and sub-divided ..... Lloyd L. Jensen, County Surveyor, in accordance with the State Laws and Instructions of the Commissioner of the General Land office, and recorded on pages ..... of Register in the County Clerk's office. By W. L. H.

Witness my hand this ..... day of ..... A. D. 1

..... SURVEYOR.

DESCRIPTION


250

OF SECTION, QUARTER SECTION AND QUARTER QUARTER SECTION CORNERS

H. C. MILLER CO., MFG. STATIONERS, MILWAUKEE X15000

GOVERNMENT CORNERS	Bearing Trees	In. Dia.	Courses they bear	Links Distant	Bearing Trees	In. Dia.	Courses they bear	Links Distant	Bearing Trees	In. Dia.	Courses they bear	Links Distant	Bearing Trees	In. Dia.	Courses they bear	Links Distant
No.																
1. N. W. Sec. Cor. indentified,																
2. N. E. Sec. Cor. indentified,																
3. S. E. Sec. Cor. indentified,																
4. S. W. Sec. Cor. indentified,																
5. N. ¼ Sec. Cor. indentified,																
6. E. ¼ Sec. Cor. indentified,																
7. S. ¼ Sec. Cor. indentified,																
8. W. ¼ Sec. Cor. indentified,																
Subdivision Corners																
No.																
1. Center ¼ Sec. Cor.																
2. North ¼-¼s N. W. qr.,																
3. East ¼-¼s N. W. qr.,																
4. South ¼-¼s N. W. qr.,																
5. West ¼-¼s N. W. qr.,																
6. Center ¼-¼s N. W. qr.,																
7. North ¼-¼s N. E. qr.,																
8. East ¼-¼s N. E. qr.,																
9. South ¼-¼s N. E. qr.,																
10. Center ¼-¼s N. E. qr.,																
11. East ¼-¼s S. E. qr.,																
12. South ¼-¼s S. E. qr.,																
13. West ¼-¼s S. E. qr.,																
14. Center ¼-¼s S. E. qr.,																
15. South ¼-¼s S. W. qr.,																
16. West ¼-¼s S. W. qr.,																
17. Center ¼-¼s S. W. qr.																

No. 788

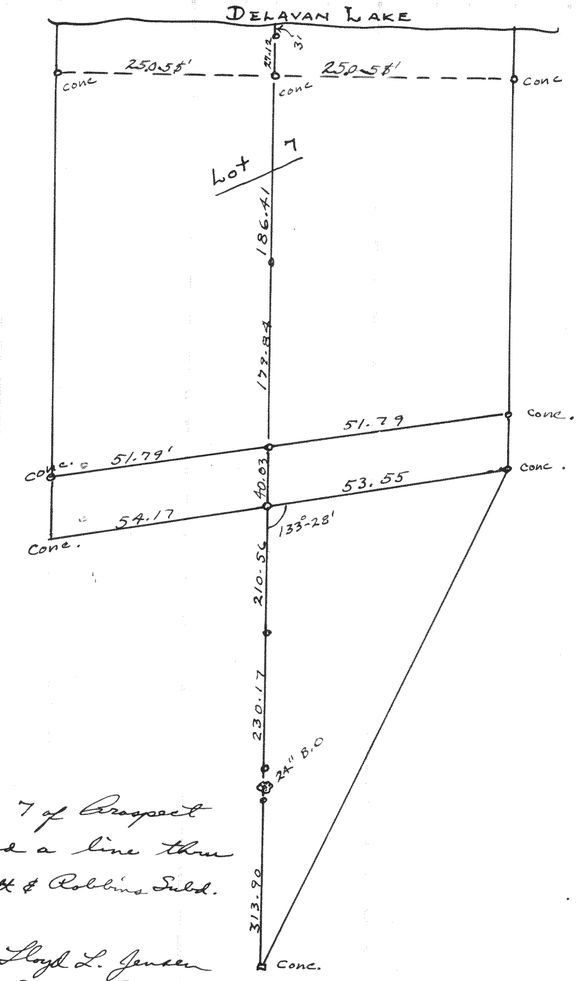


Survey of Lot 7 of Prospect Point Subd. and a line thru Lot 4 of Abbott & Robbins Subd. Oct. 1936

Lloyd L. Jensen
County Surveyor
By W. L. H.

NAMES OF SWORN ASSISTANTS

CHAINMEN	FLAGMEN	AXMEN

No. 789

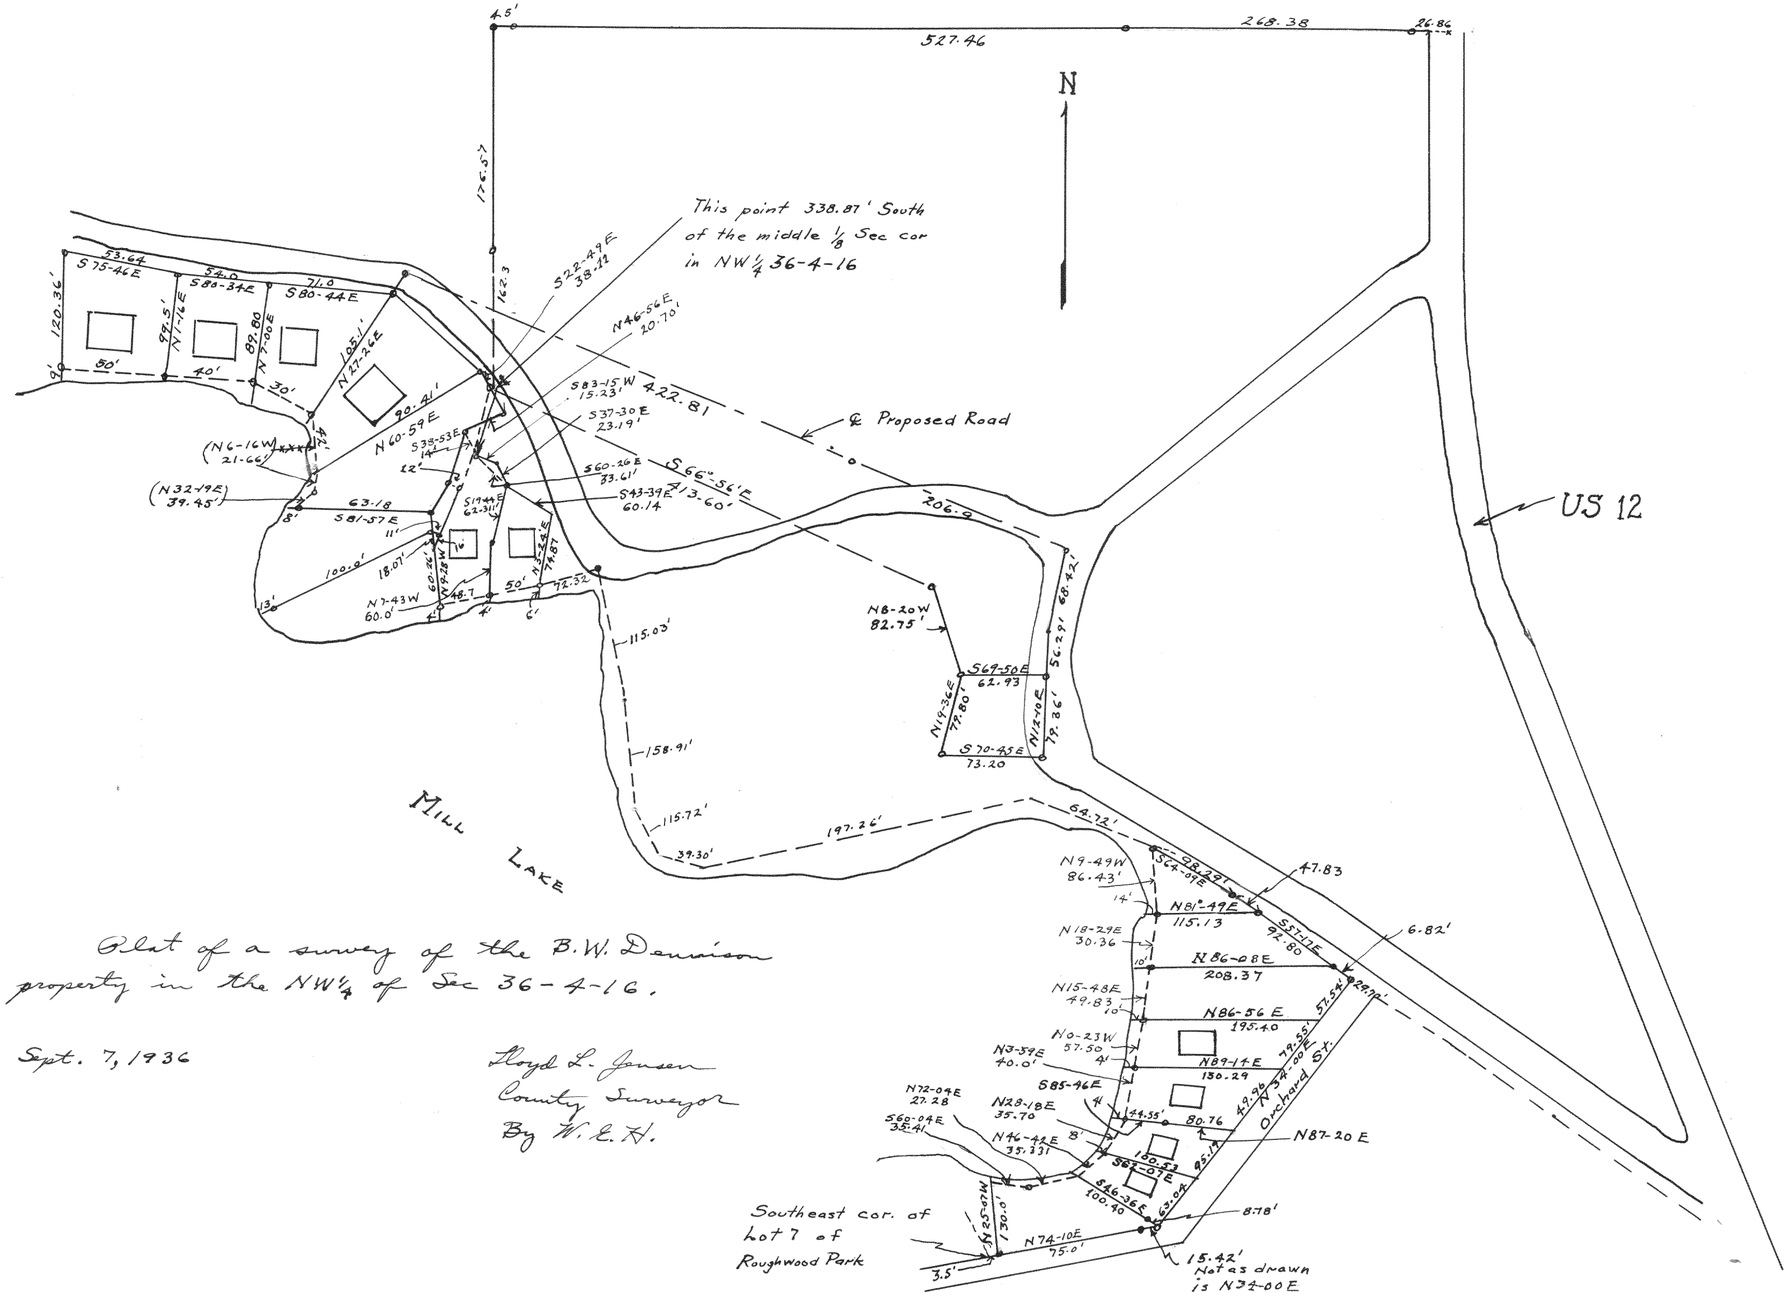

Plat of a survey of the B.W. Dennison property in the NW1/4 of Sec 36-4-16.

Sept. 7, 1936

Floyd L. Jensen
County Surveyor
By W.E.H.