Record of Survey.

No. 801


Township....., North of Range.....of 4 Principal Meridian as presented by the courses and distances on the following plat, and annexed field-notes of survey:

Established the center of the section at the point of intersection of STRAIGHT quarter lines.

Established all quarter-quarter corners upon the section boundary at proportional distances between known section and quarter section corners, according to the original field-notes of the Government survey.

Established all lost corners at proportionate distances between known corners, according to the original field notes of the Government survey.

Survey of Lots 16 & 17 of Lake Geneva Beach

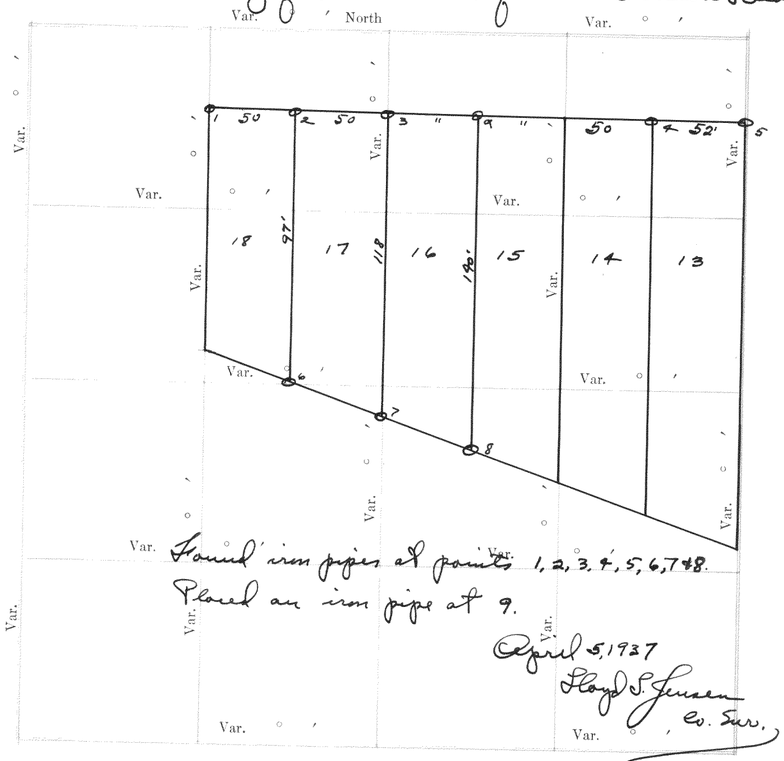

Plat of Section....., Township.....North, Range.....of 4 Principal Meridian Scale 80 chains to 6 inches. The figures in red ink are the lengths of the lines as stated in the field-notes of the Government survey.

Declination of the Magnetic Meridian from the True Meridian.....

Surveyed and sub-divided.....A. D. 1 , in accordance with the State Laws and Instructions of the Commissioner of the General Land office, and recorded on pages .....of Register in the County Clerk's office.

Witness my hand this.....day of.....A. D. 1

.....SURVEYOR.

DESCRIPTION

254

OF SECTION, QUARTER SECTION AND QUARTER QUARTER SECTION CORNERS

H. C. MILLER CO., MFG. STATIONERS, MILWAUKEE X15000


GOVERNMENT CORNERS	Bearing Trees	In. Dia.	Courses they bear	Links Distant	Bearing Trees	In. Dia.	Courses they bear	Links Distant	Bearing Trees	In. Dia.	Courses they bear	Links Distant	Bearing Trees	In. Dia.	Courses they bear	Links Distant
No.																
1. N. W. Sec. Cor. indentified,																
2. N. E. Sec. Cor. indentified,																
3. S. E. Sec. Cor. indentified,																
4. S. W. Sec. Cor. indentified,																
5. N. ¼ Sec. Cor. indentified,																
6. E. ¼ Sec. Cor. indentified,																
7. S. ¼ Sec. Cor. indentified,																
8. W. ¼ Sec. Cor. indentified,																
Subdivision Corners																
No.																
1. Center ¼ Sec. Cor.																
2. North ¼-⅛s N. W. qr.,																
3. East ¼-⅛s N. W. qr.,																
4. South ¼-⅛s N. W. qr.,																
5. West ¼-⅛s N. W. qr.,																
6. Center ¼-⅛s N. W. qr.,																
7. North ¼-⅛s N. E. qr.,																
8. East ¼-⅛s N. E. qr.,																
9. South ¼-⅛s N. E. qr.,																
10. Center ¼-⅛s N. E. qr.,																
11. East ¼-⅛s S. E. qr.,																
12. South ¼-⅛s S. E. qr.,																
13. West ¼-⅛s S. E. qr.,																
14. Center ¼-⅛s S. E. qr.,																
15. South ¼-⅛s S. W. qr.,																
16. West ¼-⅛s S. W. qr.,																
17. Center ¼-⅛s S. W. qr.																

CHAINMEN

NO. 802

Survey of Block 20 of Chapman and Ludington's Add. to City of Whitewater.

original plat gives each lot as 66 x 142

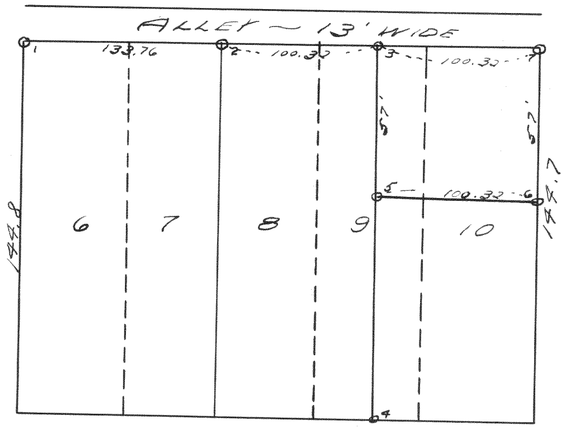

Found I. P. at 1, 2, 3 & 4 as set by Harry Bripse as shown in Note #12
Set pipe at 5
Cut notch in walk at 6 & 7

Feb. 5, 1937
Floyd S Jensen
By A. C. J.

NAMES OF SWORN ASSISTANTS

FLAGMEN	AXMEN

No 803 — Survey made of limits of the village of Fontana-on-Geneva-Lake, Wal. Co., Wis. and described as follows, to-wit: Commencing at the East ¼ section corner of section (13), Town (1) North, Range (16) East; thence North 1063 feet to the shore of Geneva Lake, which point is the place of beginning; thence N 63°-01'W 804.4 feet to a point on the shore of Geneva Lake which point is the Northeasterly corner of land owned by C. Stiger and is located in the SW¼ NE¼ (11) Town one north, Range 16 East, thence following the shore of Geneva Lake along the following courses S 36°-27'W 181.12 feet; thence S 20°-44'W 204.15 feet; thence southerly 412 feet; thence S 33°-35'W 396.21 feet; thence S 51°-32'W 283.53 feet; thence S 74°-54'W 288.65 feet; thence S 26°-34'W 248.22 feet; thence S 16°-44'W 272.57 feet; thence S 12°-38'W 246.78 feet; thence S 14°-16'W 534.71 feet; thence S 5°-53'W 345.73 feet; thence S 13°-32'W 123.00 feet; thence S 20°-36'W 325.1⅘ feet; thence S 21°-42'W 342.17 feet; thence S 1°-17'W 320.24 feet; thence S 1°-28'W 234.55 feet; thence S 25°-09'E 1,019.80 feet; thence S 33°-30'E 959.91 feet; thence S 66°-16'E 282.62 feet; thence N 81°-09'E 676.10 feet; thence S 89°-53'E 322.17 feet; thence N 58°-33'E 188.85 feet; thence N 29°-51'E 237.93 feet; thence N 54°-58'E 187.06 feet; thence N 58°-18'E 209.32 feet; thence N 78°-11'E 527.94 feet; thence S 86°-29'E 458.95 feet; thence N 63°-13'E 354.60 feet; thence N 23°39'E 524.60 feet; thence S 88°-22'E 377.79 feet; thence N 87°-49'E 524.1 feet; thence N 64°-11'E 591.52 feet; thence S 76°-13'E 169.49 feet; thence S 88°-45'E 133.41 feet; thence S 70°-26'E 106.98'; thence S 87°-33'E 257.75'; thence N 83°-00'E 361.78'; thence N 63°-23'E 184.51'; thence N 89°-56'E 318.47'; thence N 76° 22' 562.67'; thence N 61°-15'E 240.14'; thence N 71°-58'E 400.38; thence N 61°-39'E 225.0; thence N 75°-42'E 123.10'; thence N 66°-13'E 139.38'; to the place of beginning, containing 601 acres more or less.

Lloyd L. Jensen
by H.E.J.

