Record of Survey.


No. 61

Township....., North of Range.....of 4 Principal Meridian as presented by the courses and distances on the following plat, and annexed field-notes of survey:

Established the center of the section at the point of intersection of STRAIGHT quarter lines.

Established all quarter-quarter corners upon the section boundary at proportional distances between known section and quarter section corners, according to the original field-notes of the Government survey.

Established all lost corners at proportionate distances between known corners, according to the original field notes of the Government survey.

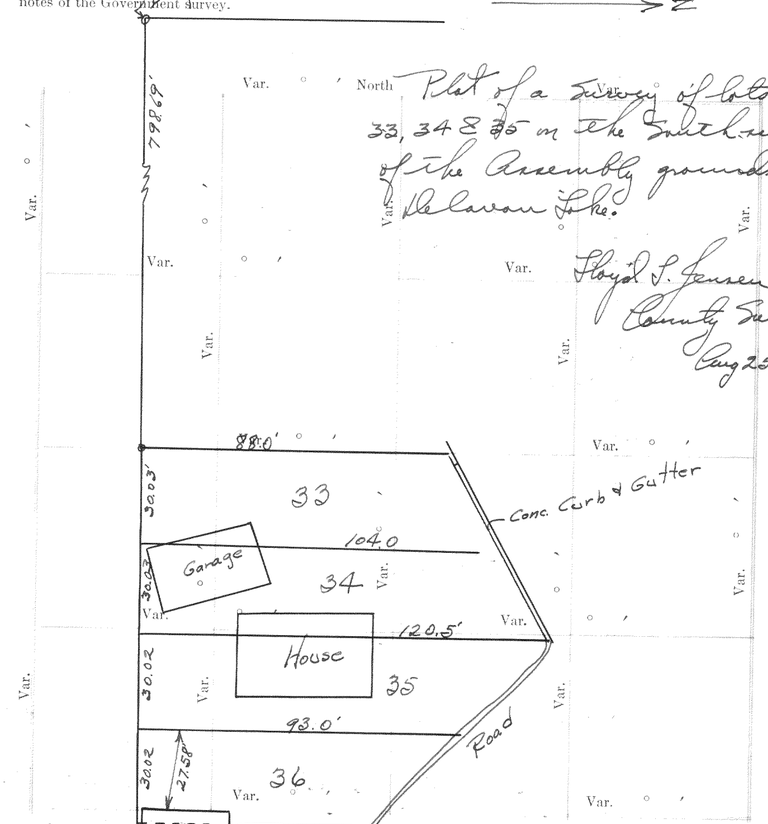

Plat of Section..... Township.....North, Range.....of 4 Principal Meridian Scale 80 chains to 6 inches. The figures in red ink are the lengths of the lines as stated in the field-notes of the Government survey.

Declination of the Magnetic Meridian from the True Meridian.....

Surveyed and subdivided.....A. D. 1 ; in accordance with the State Laws and Instructions of the Commissioner of the General Land Office, and recorded on pages ..... of Register in the County Clerk's office.

Witness my hand this.....day of.....A. D. 1

.....SURVEYOR.

DESCRIPTION

OF SECTION, QUARTER SECTION AND QUARTER QUARTER SECTION CORNERS

H. C. MILLER CO., MFG. STATIONERS, MILWAUKEE X15000

GOVERNMENT CORNERS	Bearing Trees	In. Dia.	Courses they bear	Links Distant	Bearing Trees	In. Dia.	Courses they bear	Links Distant	Bearing Trees	In. Dia.	Courses they bear	Links Distant	Bearing Trees	In. Dia.	Courses they bear	Links Distant
No.																
1. N. W. Sec. Cor. indentified,																
2. N. E. Sec. Cor. indentified,																
3. S. E. Sec. Cor. indentified,																
4. S. W. Sec. Cor. indentified,																
5. N. ¼ Sec. Cor. indentified,																
6. E. ¼ Sec. Cor. indentified,																
7. S. ¼ Sec. Cor. indentified,																
8. W. ¼ Sec. Cor. indentified,																
Subdivision Corners																
No.																
1. Center ¼ Sec. Cor.																
2. North ¼-¼s N. W. qr.,																
3. East ¼-¼s N. W. qr.,																
4. South ¼-¼s N. W. qr.,																
5. West ¼-¼s N. W. qr.,																
6. Center ¼-¼s N. W. qr.,																
7. North ¼-¼s N. E. qr.,																
8. East ¼-¼s N. E. qr.,																
9. South ¼-¼s N. E. qr.,																
10. Center ¼-¼s N. E. qr.,																
11. East ¼-¼s S. E. qr.,																
12. South ¼-¼s S. E. qr.,																
13. West ¼-¼s S. E. qr.,																
14. Center ¼-¼s S. E. qr.,																
15. South ¼-¼s S. W. qr.,																
16. West ¼-¼s S. W. qr.,																
17. Center ¼-¼s S. W. qr.																

No. 62



Plat of survey for Mrs. Wadsworth

Location Sec. 27, T2. N., R15E

April 24, 1933

Floyd S. Jensen
County Surveyor

CHAINMEN


NAMES OF SWORN ASSISTANTS

FLAGMEN

AXMEN

No. 63

The Lyons Milk Company

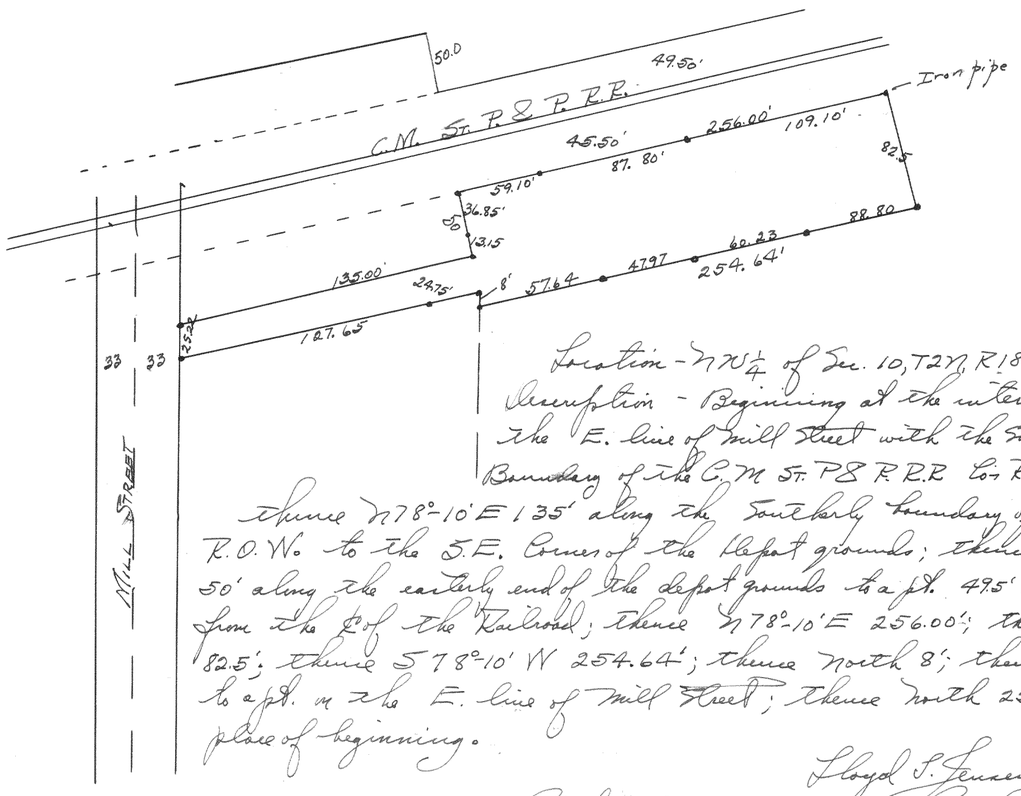


Location - NW¼ of Sec. 10, T27N, R18E.

Description - Beginning at the intersection of the E. line of Mill Street with the Southerly Boundary of the C.M St P&R R.R Co's R.O.W.; thence N78°-10'E 135' along the Southerly boundary of said R.O.W. to the S.E. Corner of the depot grounds; thence N11°50W 50' along the easterly end of the depot grounds to a pt. 49.5' distant from the C of the Railroad; thence N78°-10'E 256.00'; thence S11°-50'E 82.5'; thence S78°-10'W 254.64'; thence North 8'; thence S78°-10'W to a pt. in the E. line of Mill Street; thence North 25.25' to the place of beginning.

Lloyd S. Jensen
County Surveyor

April 10, 1933

No. 64

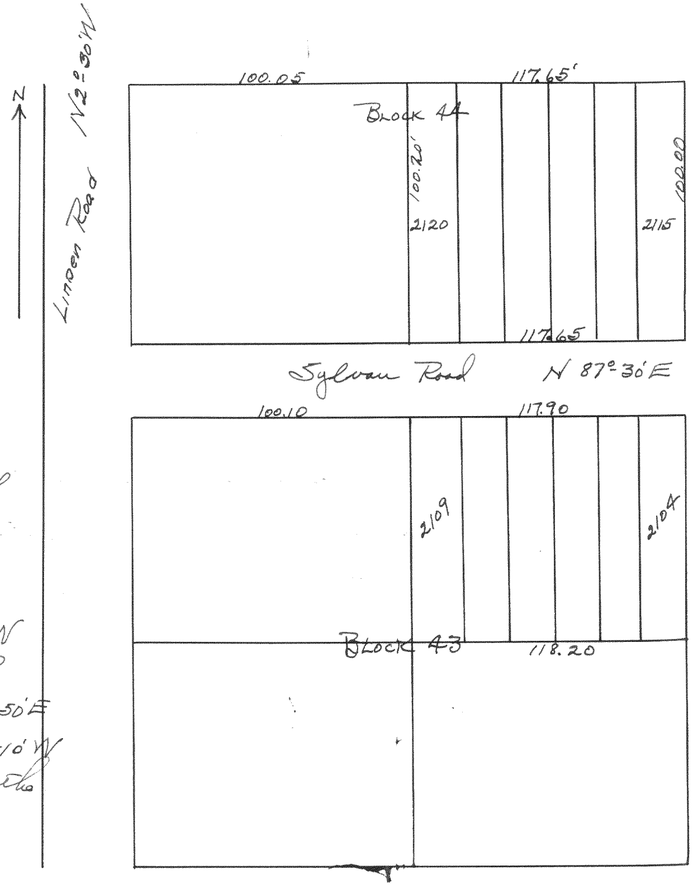

Survey of lots for E. W. English Jr.
Location - in Section 2 of Pell Lake Plats.

Lloyd S. Jensen
County Surveyor

March 29, 1933