
260

817

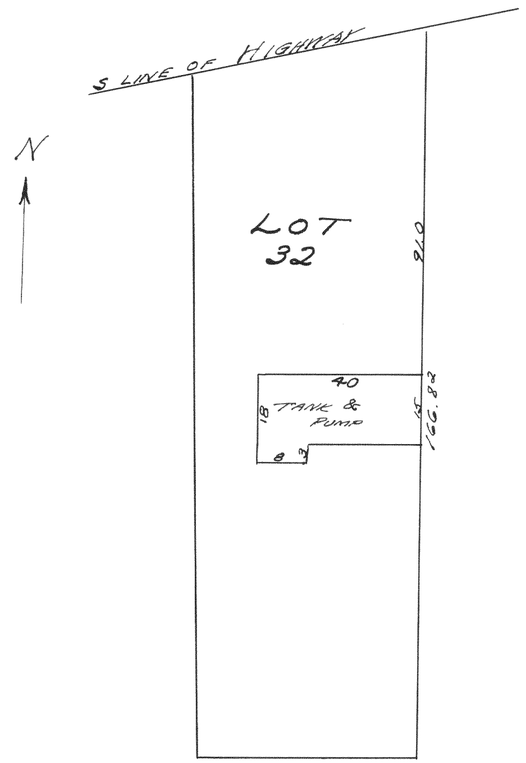


Survey of Water Tank located on lot 32 of Lake Geneva Knolls Subdivision

June, 1937

Lloyd L. Jensen
K.C.J.

No. 818

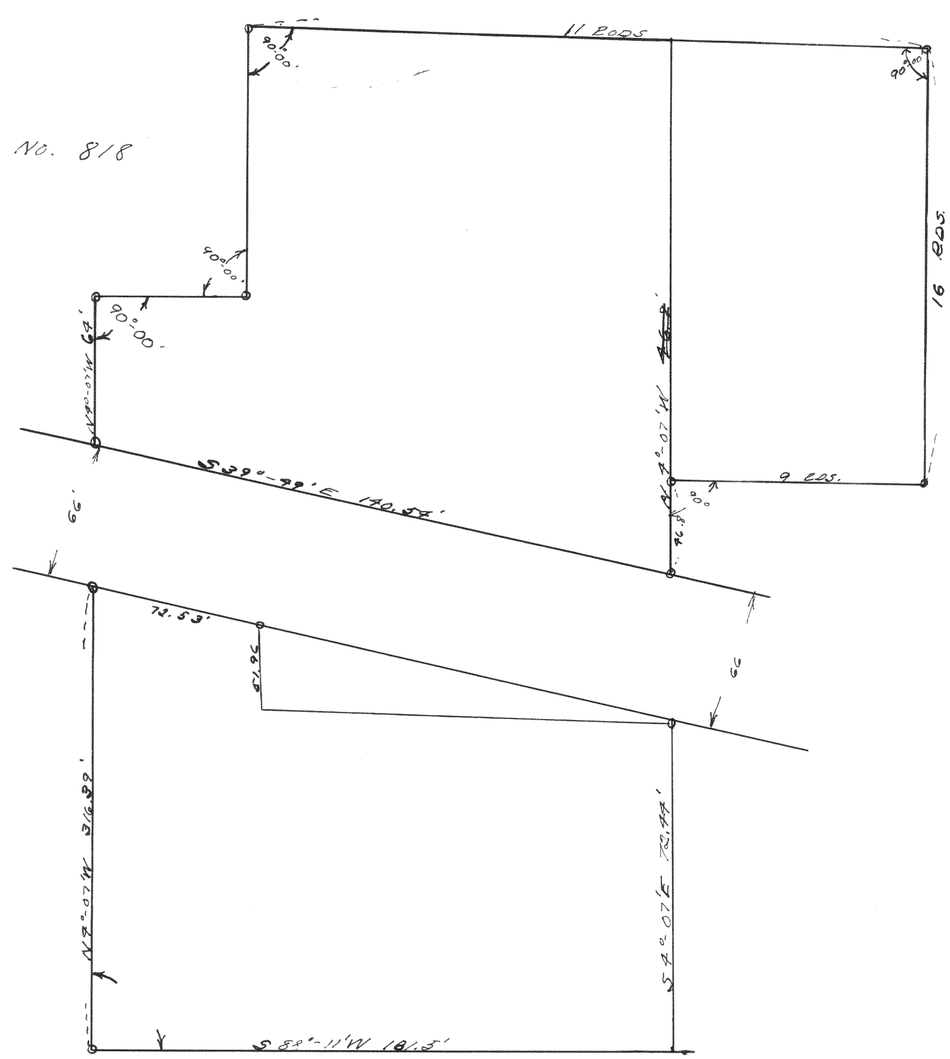

Survey made of land conveyed to Chester Price
Sec. 17-1-18

August 1937

Lloyd L. Jensen
by K.C.J.