
No 819

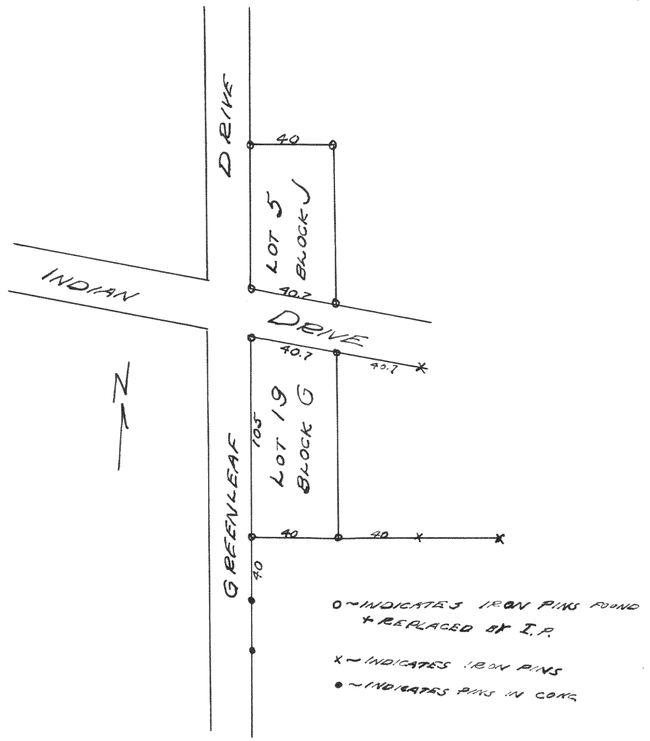

Survey of lot 19 Block G and lot 5, Block J. of Cisco Beach Subdivision.

Aug. 1937

Lloyd L. Jensen
by H.E.J.

No. 820



Survey of lots 292 - 296, inclusive, of Bell Lake Subdivision

Aug. 1937

Lloyd L. Jensen
by H.E.J.