
262

No. 821

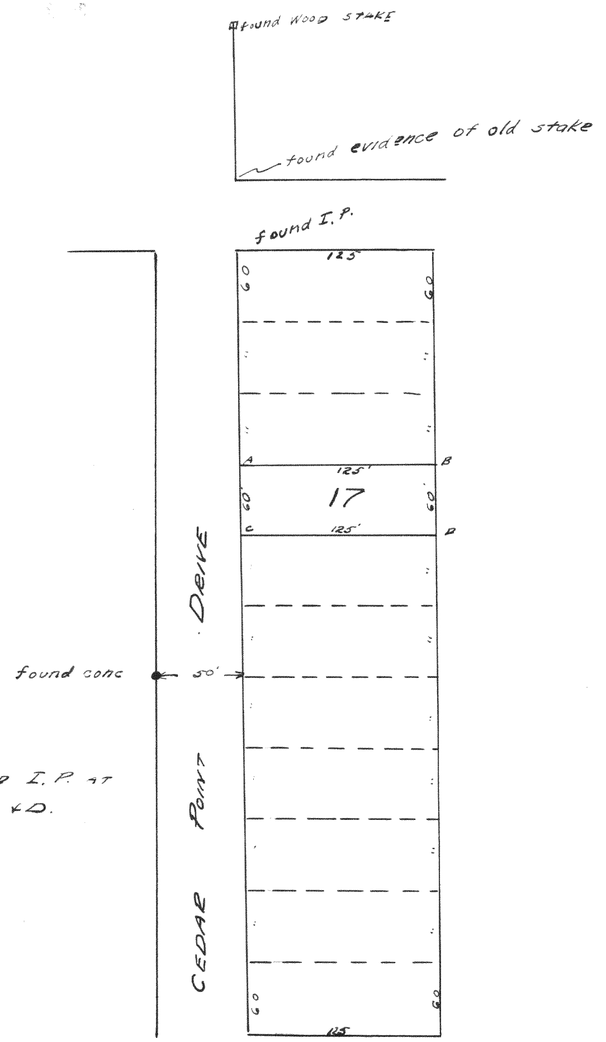


PLACED I. P. AT
A, B, C, & D.


LOT 17 CEDAR PT. PARK (ORIGINAL)

7-37

Lloyd L. Jensen
by H. E. J.

No. 822

Survey of Lot 145 of Krumhaars 2nd. Add.,
located in Section 31 2-16

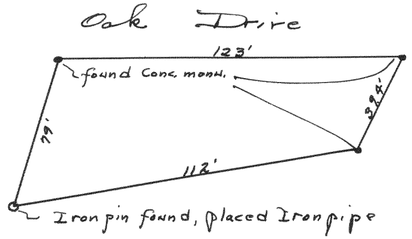


Lloyd L. Jensen
Co. Sur.
5-24-37