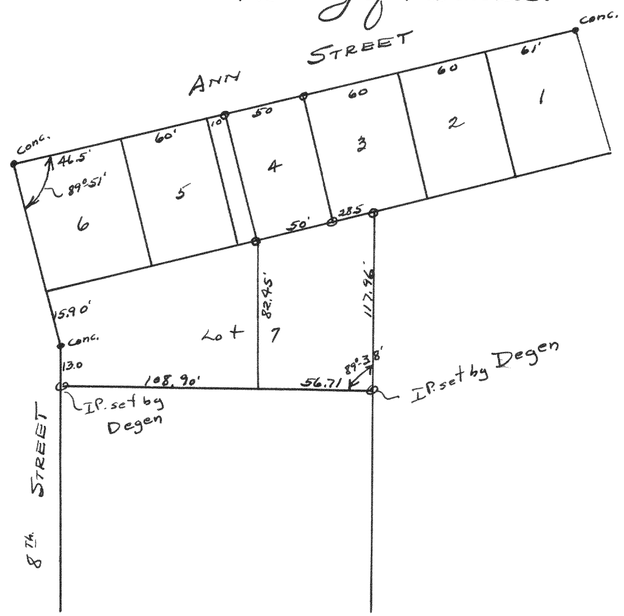
264

No. 825 Survey of part of Lots 4 and 7 of Block 20 of Passage Cram & Downies Add. to the City of Delavan.


ANN STREET
conc.
conc.
conc.