
No. 827

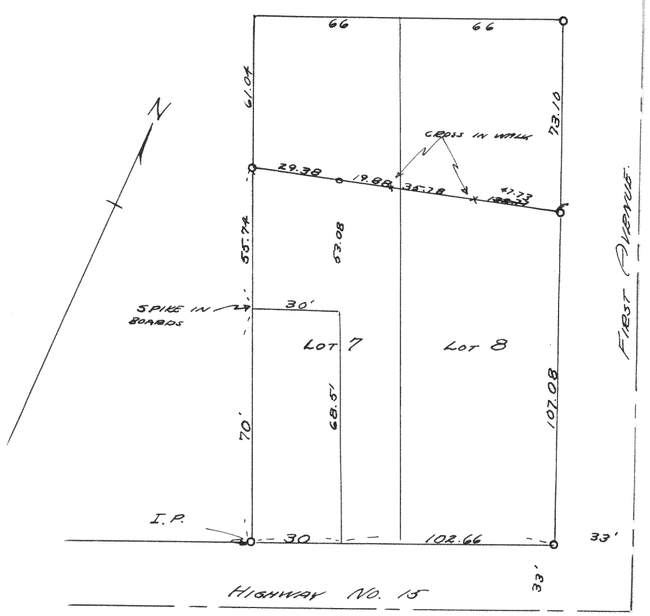


LOTS 7 & 8 OF BLOCK 8, ORIGINAL TOWN OF DARIEN — JUNE 1938

Sec-27-2-15

Lloyd L. Jensen
City E. E.

No. 828

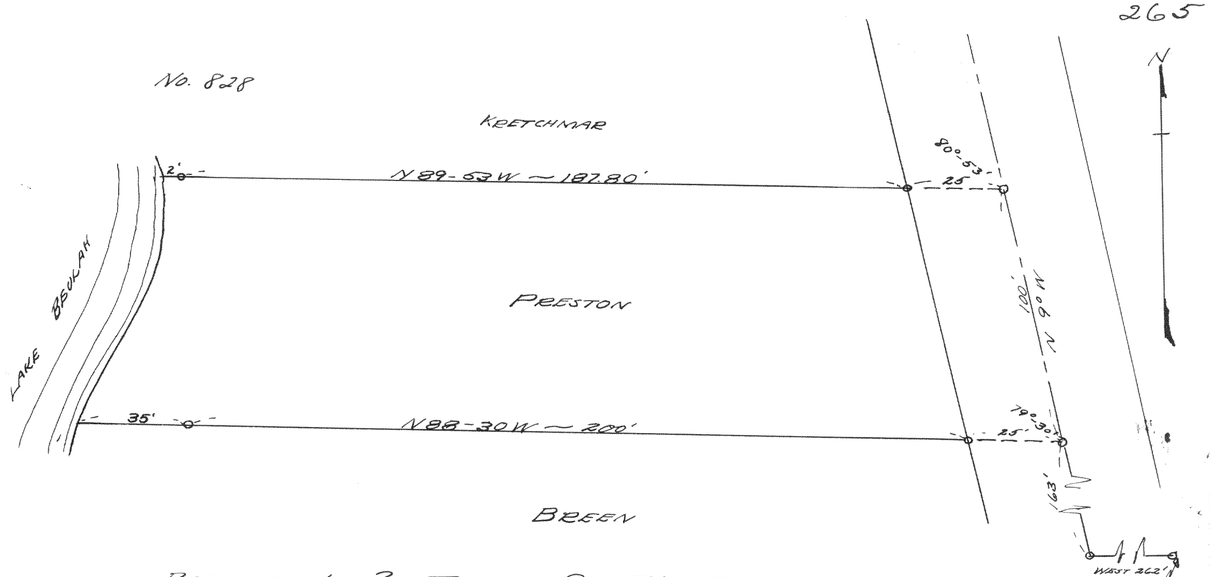

PART OF LOT 2, SECTION 9, T4N, R18E - APRIL 1938 EAST ¼ CORNER OF SECTION 9 T4N R18E

June 1938

Lloyd L. Jensen
City E. E.