
NO. 829

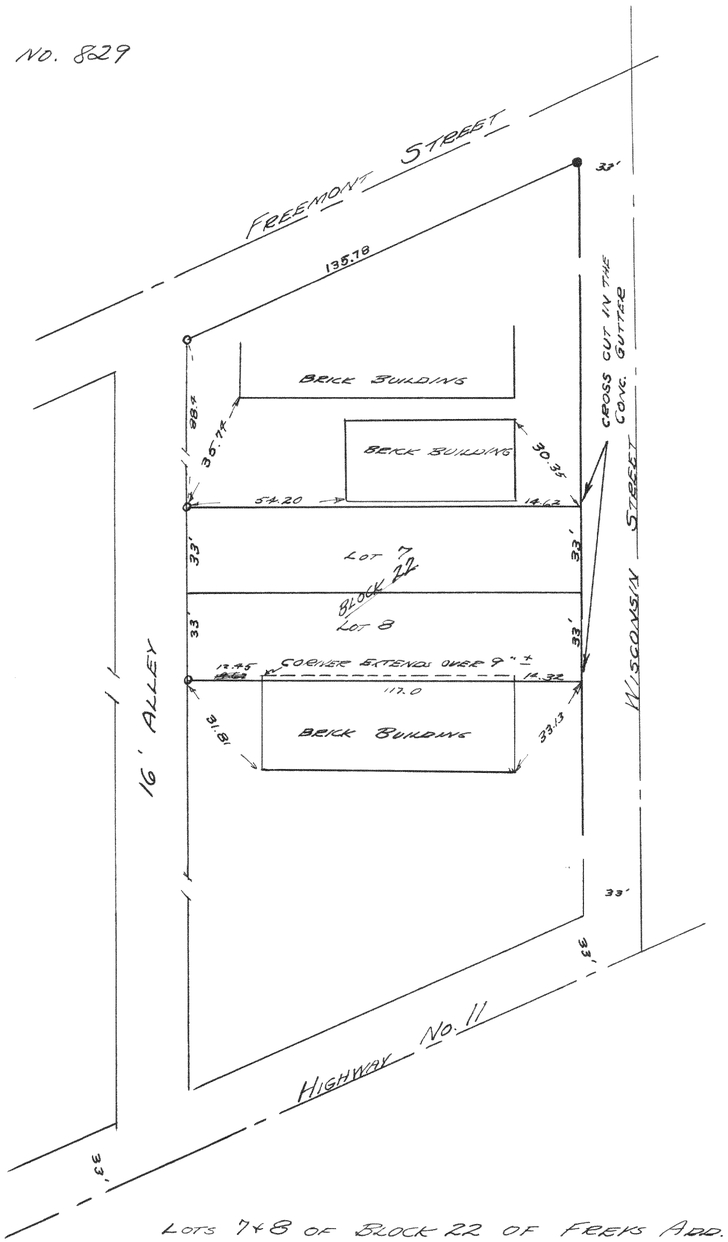


LOTS 7 & 8 OF BLOCK 22 OF FREKS ADD.
TO THE VILLAGE OF DARIEN - SEC 27-2-15

July 1938

Lloyd L Jensen
by K.E.J.

NO. 830

WALDMAN TO TWIST 11-6-37

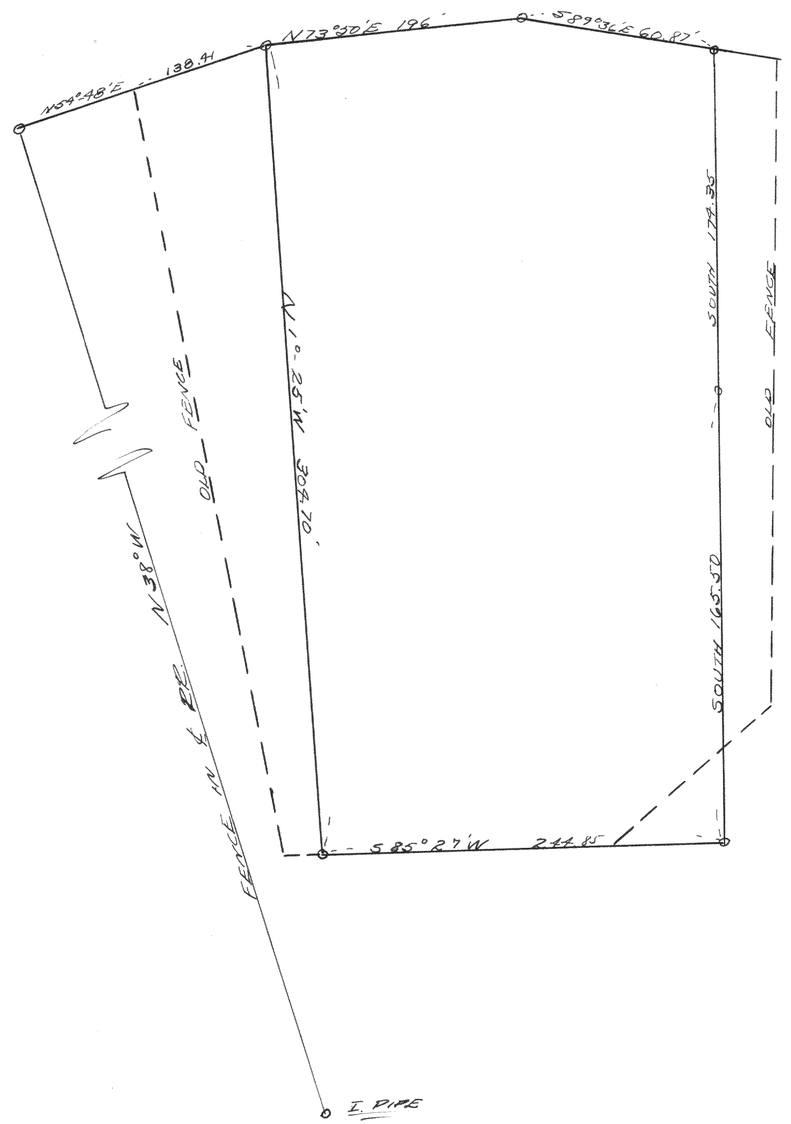

SURVEY OF PART OF SE ¼
SECTION 15 T2N R11E.

November 1937

Lloyd L. Jensen
by K. E. J.