
No. 831

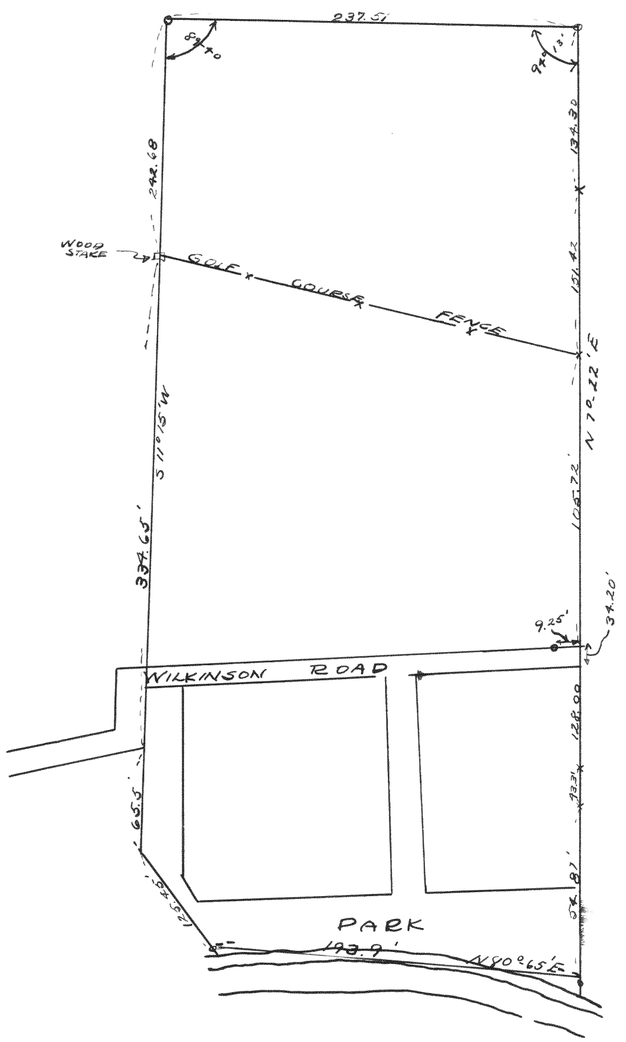


PART OF LAUDERDALE HEIGHTS
SEC. 36 - T4N R16E.

July 1938

Lloyd Jensen
by H.E.J.

No. 832

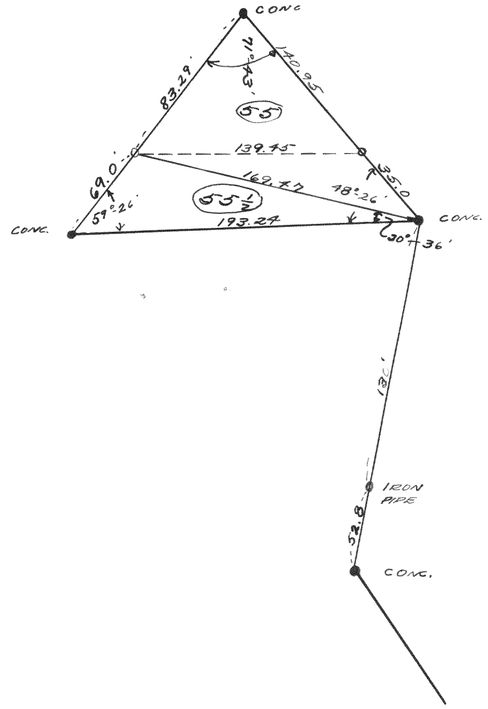


LOT 55½ & PART OF LOT 55
OF 1ST ADD. TO CEDAR PT. PARK
Sec 6-1-17

Aug. 1938

Lloyd L Jensen.
by H.E.J.

No. 833

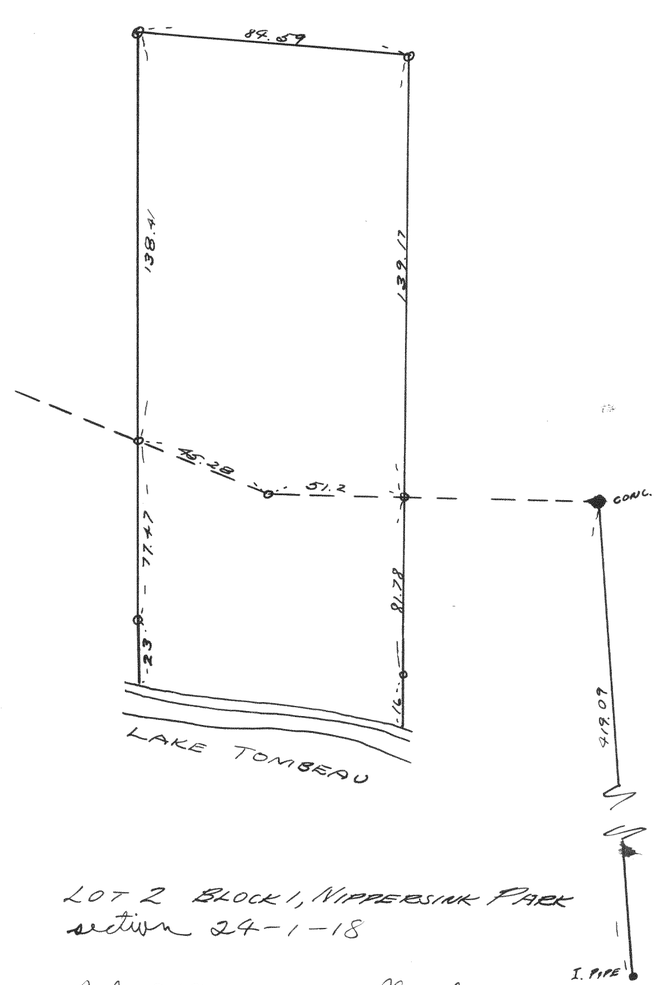

LOT 2 BLOCK 1, NIPPERSINK PARK
section 24-1-18

July 1938

Lloyd Jensen
by H.E.J.