
No. 840

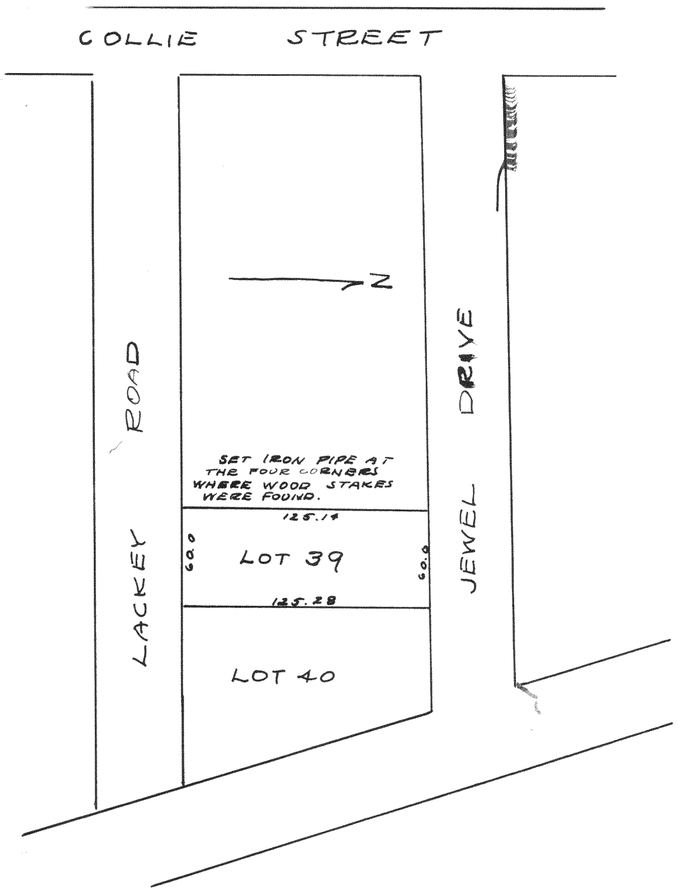


Survey made of lot 39 of Lackey Bros. Subdivision in the village of Wms. Bay.

Sept. 1937

Lloyd L. Jensen
by K.E.J.

No. 841

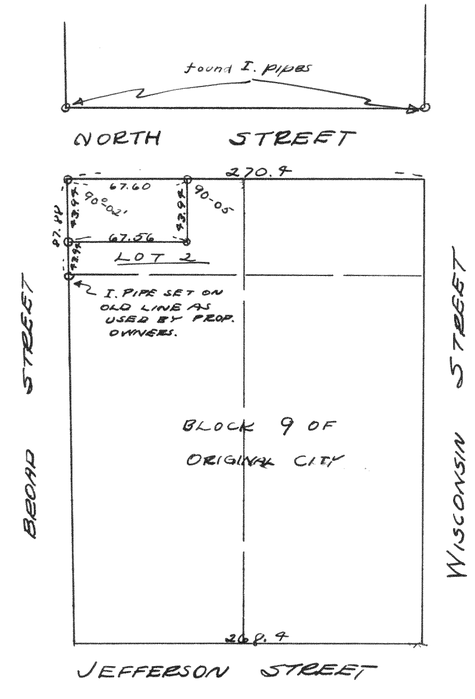


Survey of part of lot 2 block 9 of the original city of Elkhorn - sec. 31-2-17

11-22-37

Lloyd L. Jensen
by K.E.J.

No. 842

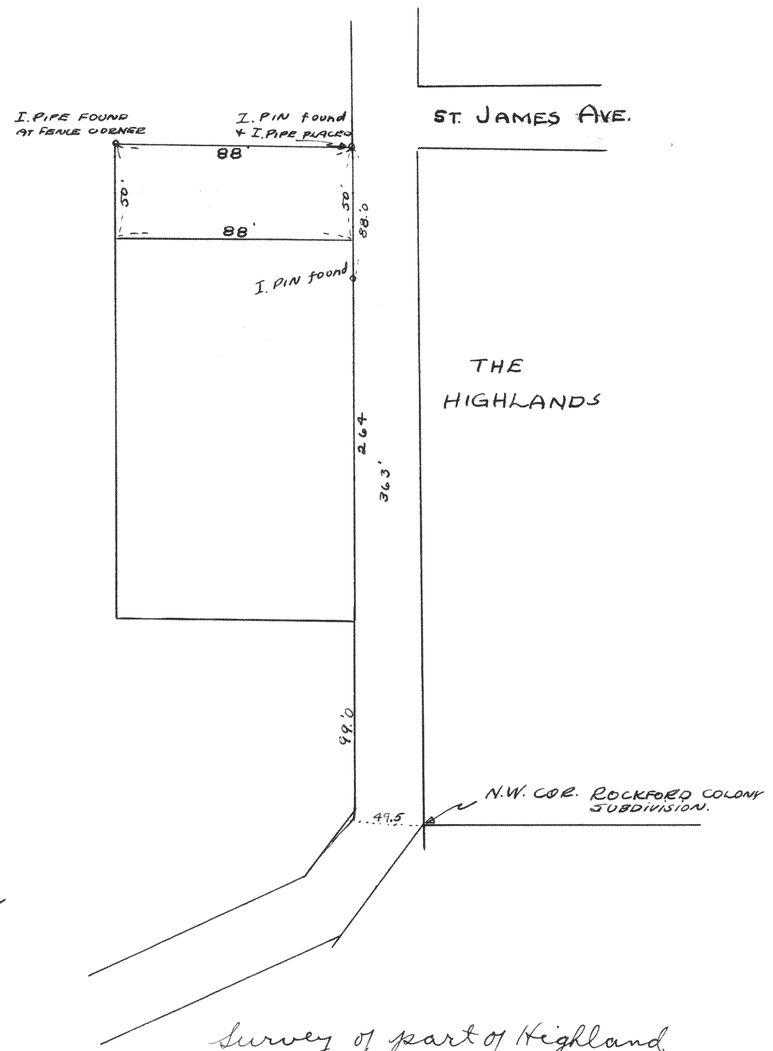

Survey of part of Highland property located in 28-2-16

11-26-37

Lloyd L. Jensen
by K.E.J.