
272

No 843

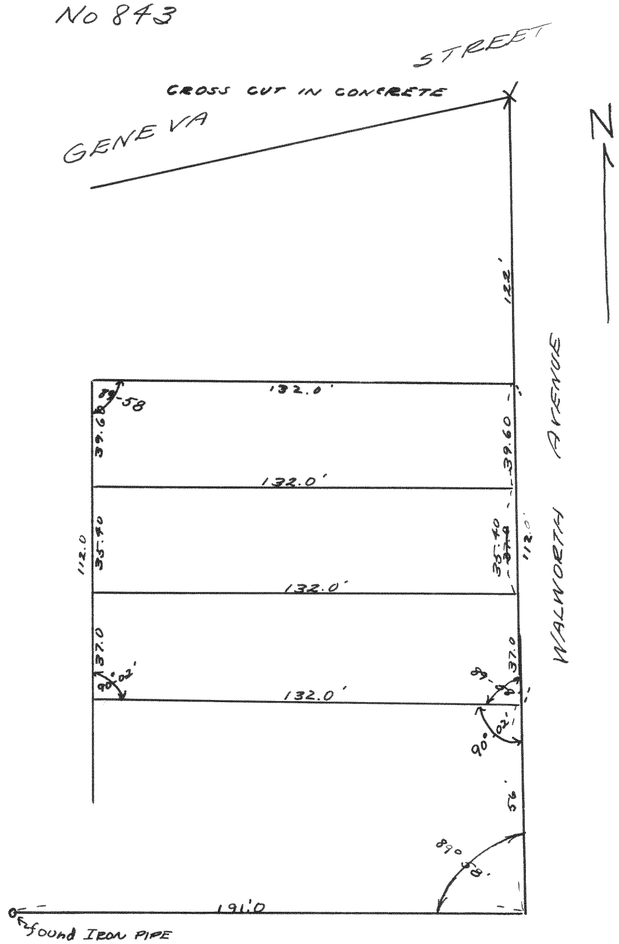


Survey of lot 1 - Blk. 4 of the original plat of Winona Bay.

11-24-26-37

Lloyd L Jensen
by H. E. J.

No. 844

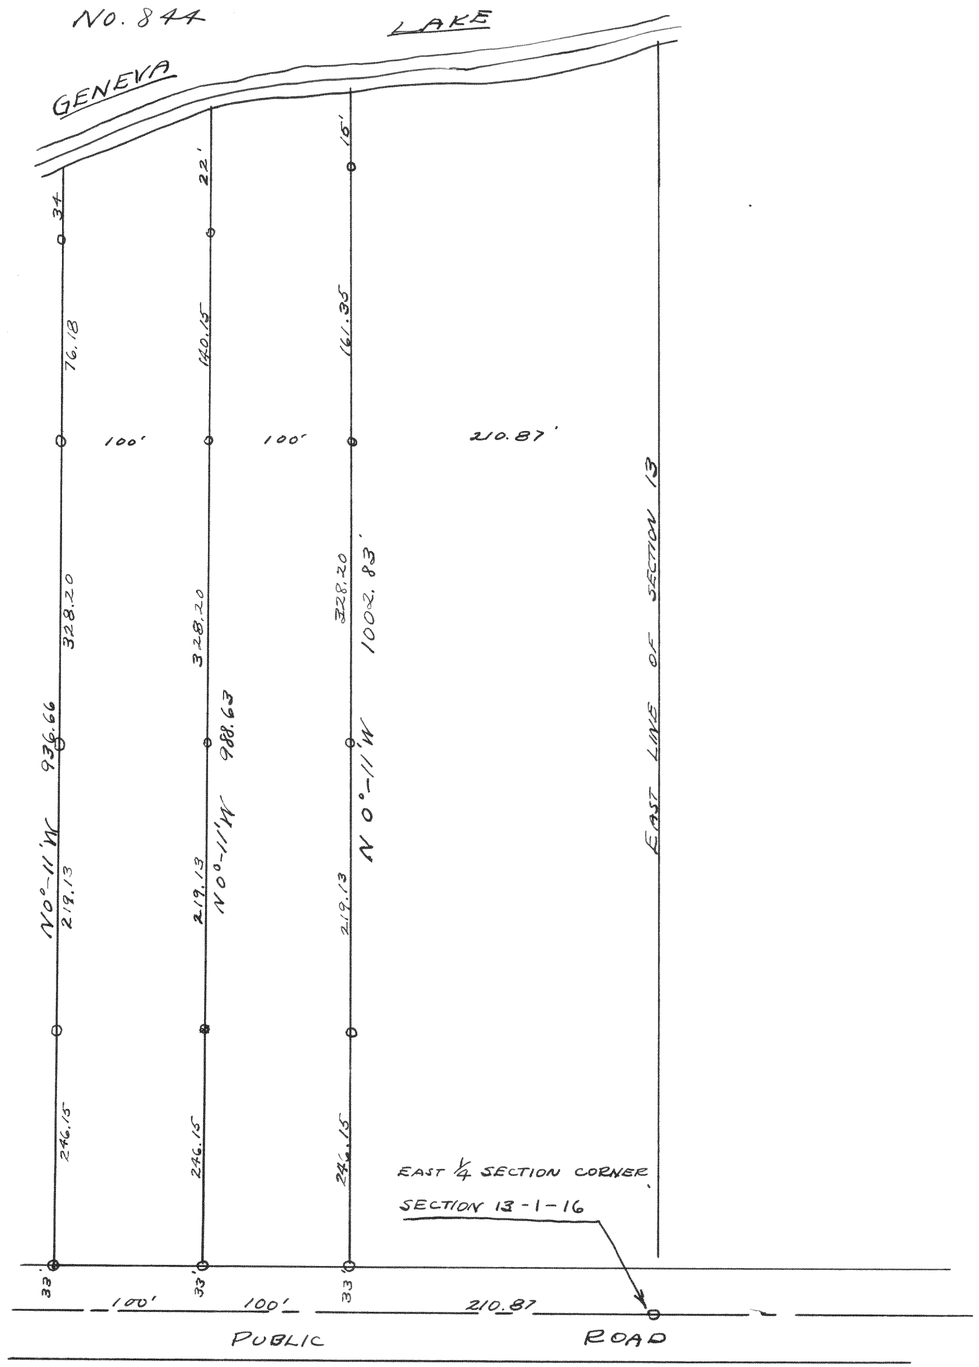

Survey of part of section 13-1-16
April 1938

Lloyd L. Jensen by H.E.J.