

NO. 851

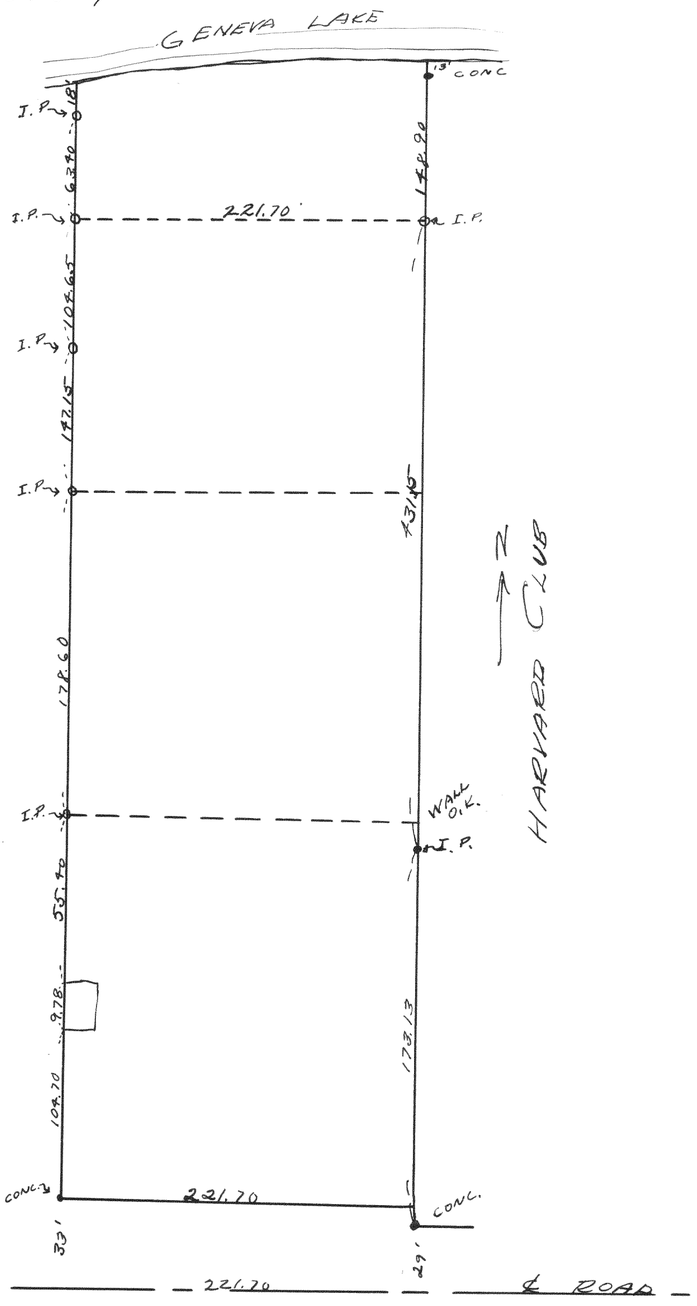

Survey of pt. of NE ¼ sec. (13-1-16)
date = 7-21-38

Lloyd L. Jensen
by H.E.J.

NO. 852

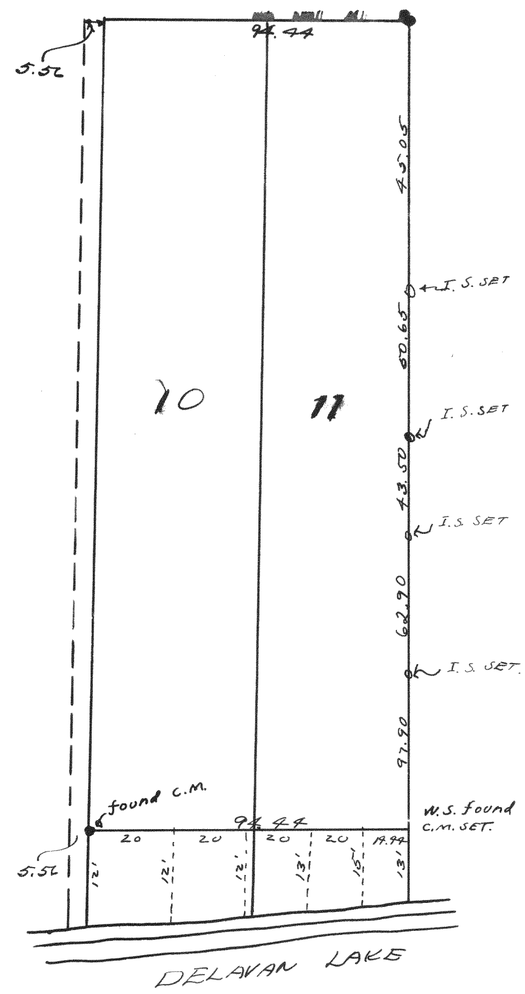


Survey of Lots 10 & 11 of Baily's Subd. in sec 27-2-16

April 9, 1938

Lloyd L. Jensen
by H.E.J.

NO. 853

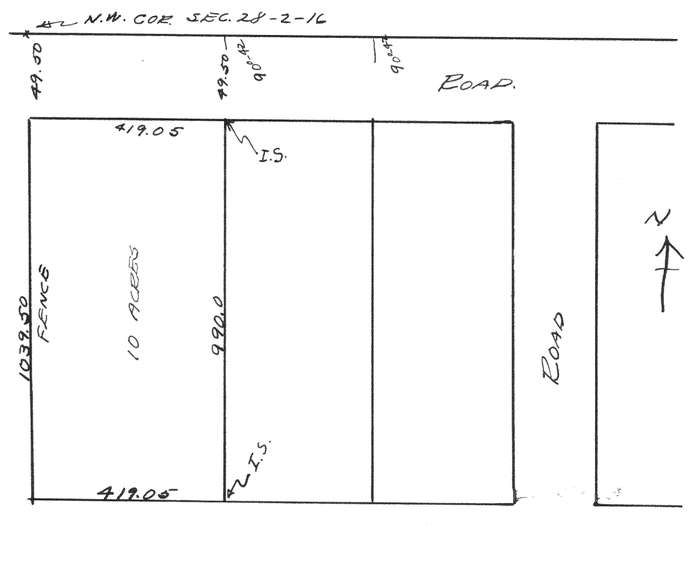

Survey of part of NW ¼ sec 28-2-16
April 10, 1938

Lloyd L. Jensen
by H.E.J.