No. 861

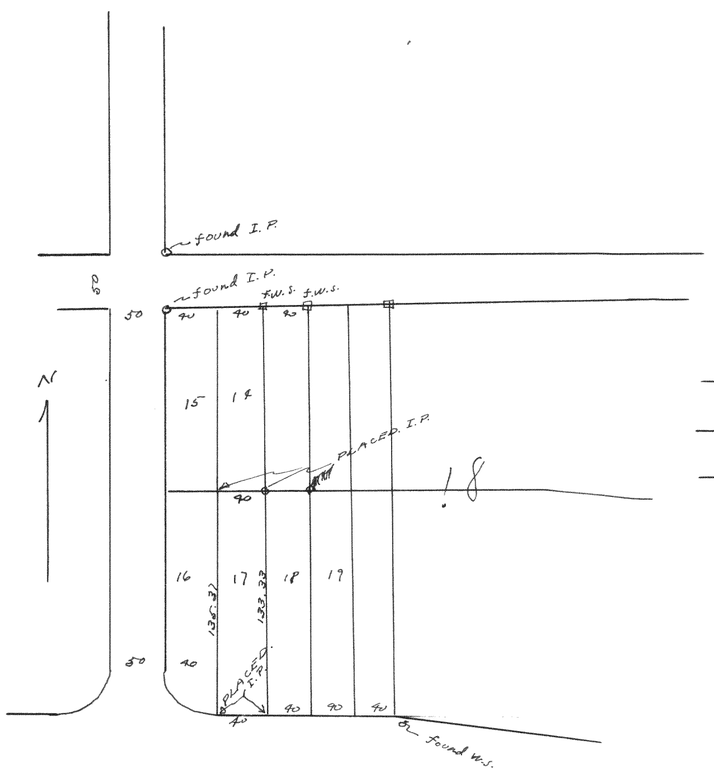

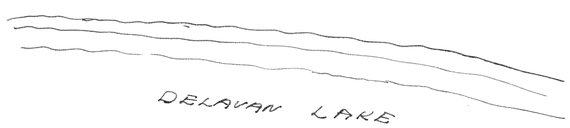

Survey of lot 16 Feb. 18 Delavan Lake View Subdivision T2N R16E

Nov. 7 - 1937

Lloyd Jensen
by H. Johnson.

No. 862

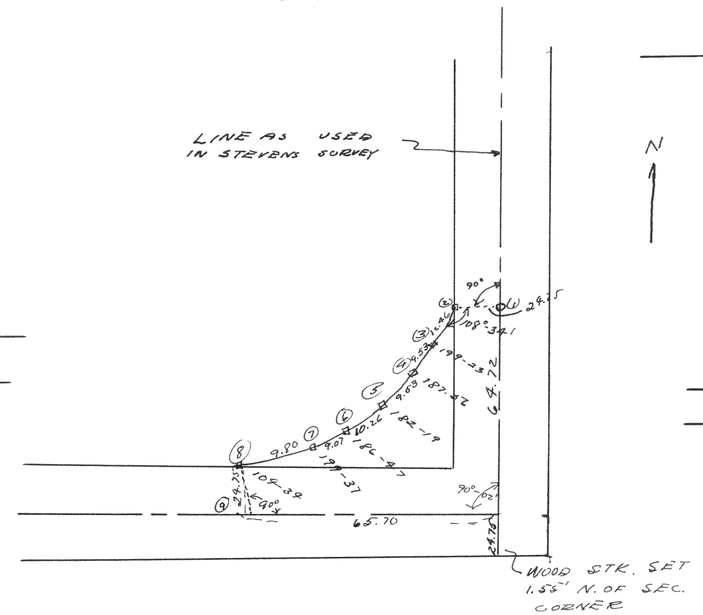

Survey of public road at sec corner of sections 29, 30, 31 & 32 T2N R16E

Nov. 1937

Lloyd Jensen
by H.E.J.

No. 863

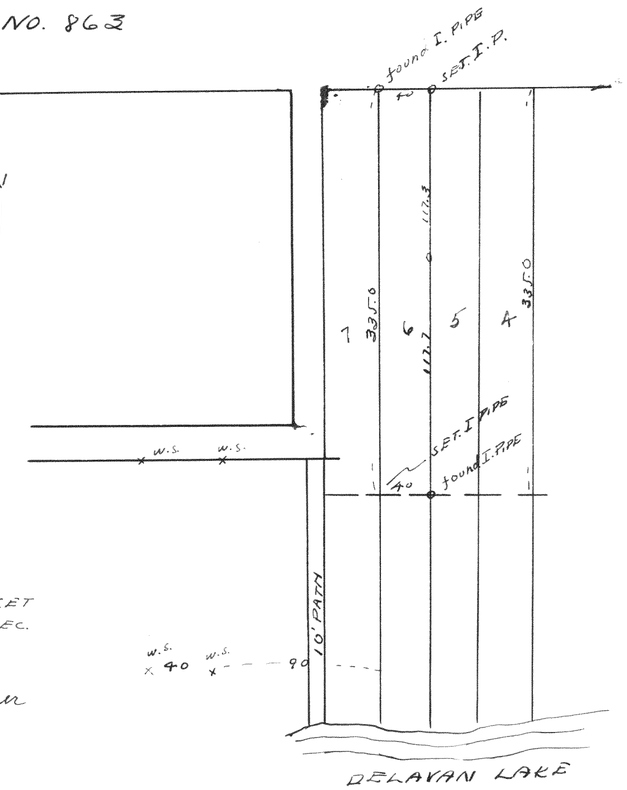

Survey of lot (6) of Rowenswood Subdivision - T2N R16E

Sept. 1937

Lloyd L. Jensen.
by H.E.J.