

No. 865

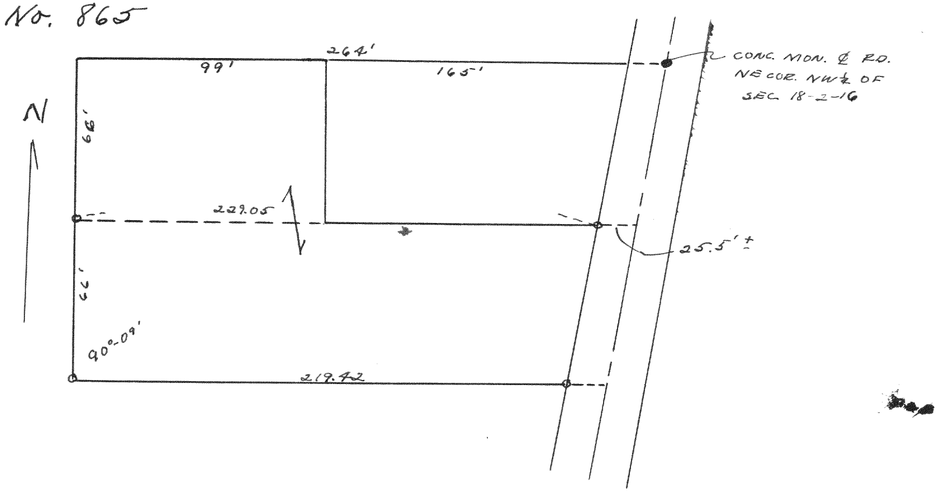

Survey of part of NW¼ 18-2-16

June 6, 1937 Lloyd L. Jensen
by K.E.J.


No. 866

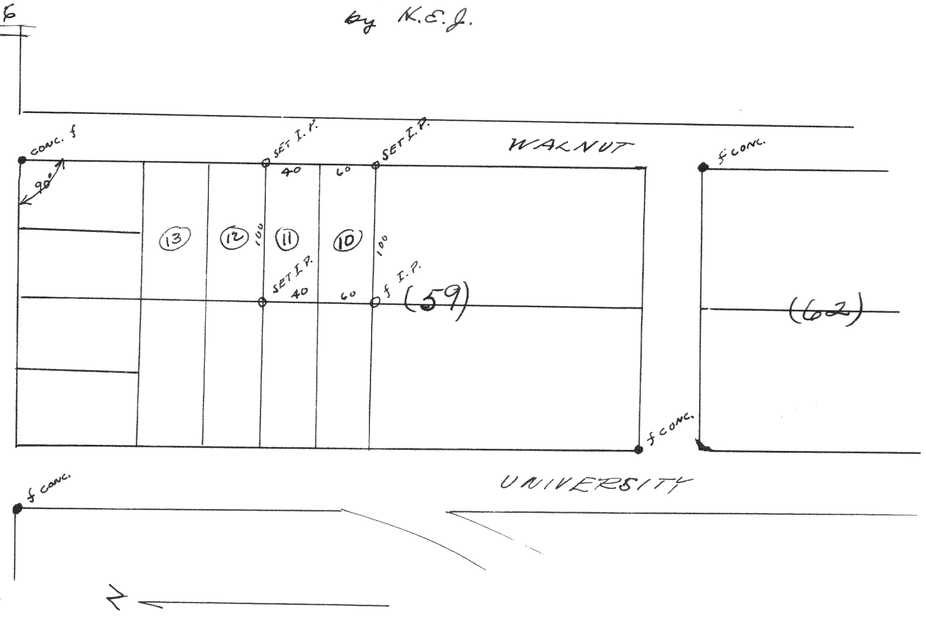

Survey of lots 10 & 11 of Pb. 59 of 4th maps of Interlaken

April 12, 1937 Lloyd L. Jensen

No. 867

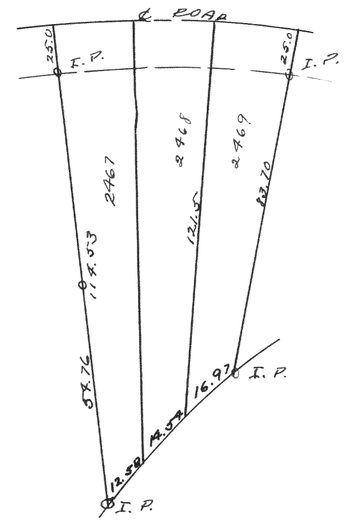


Plat of survey of lots 2467, 2468 and 2469 of the unrecorded plat of Interlaken subd. now being known as lot 322 of the recorded plat of the 4th maps of Interlaken.

Lloyd L. Jensen
by K.E.J.

November 1937

No. 868

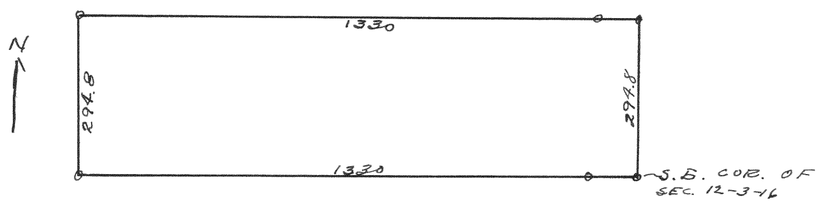

Survey to locate the bounds of 9 acres in the south end of the E ½ of the SE ¼ of section 12-3-1E — No section corners were found, fence lines were used for the work.

March 1937 Lloyd L. Jensen
by K.E.J.