
284

NO. 875

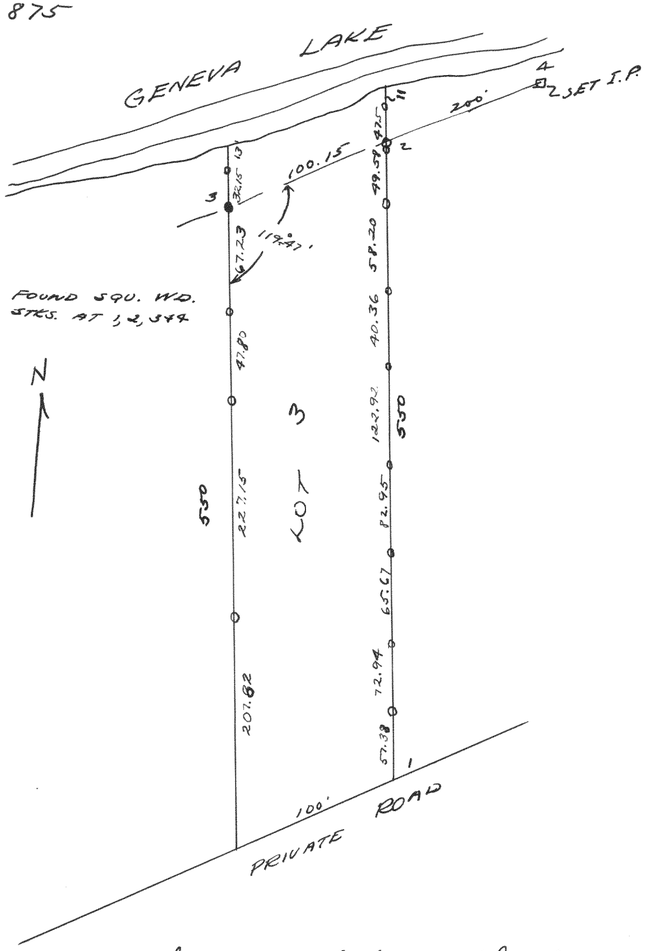


Survey of lot 3 of the Birches Subd. in sec. 10-1-17

March 1938

Lloyd Jensen by K.E.J.

NO876

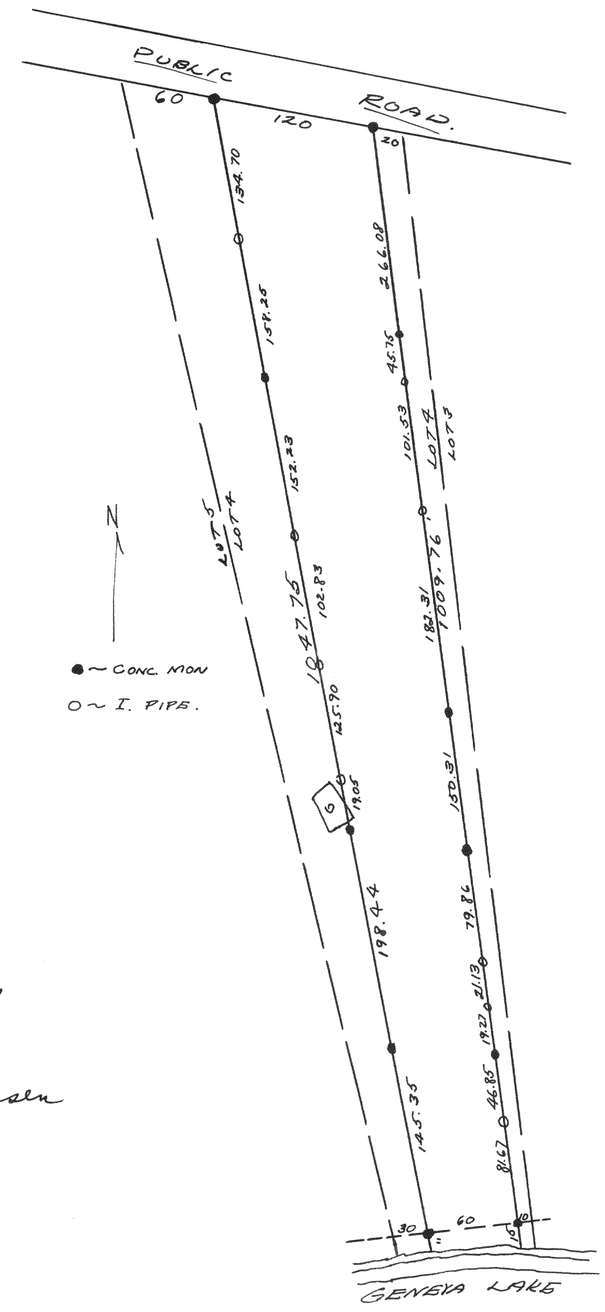


Survey of part of lot 4 of Blk. I of Kowena Park. in sec 5-1-17

Aug. 1937.

Lloyd Jensen by K.E.J.

NO. 877

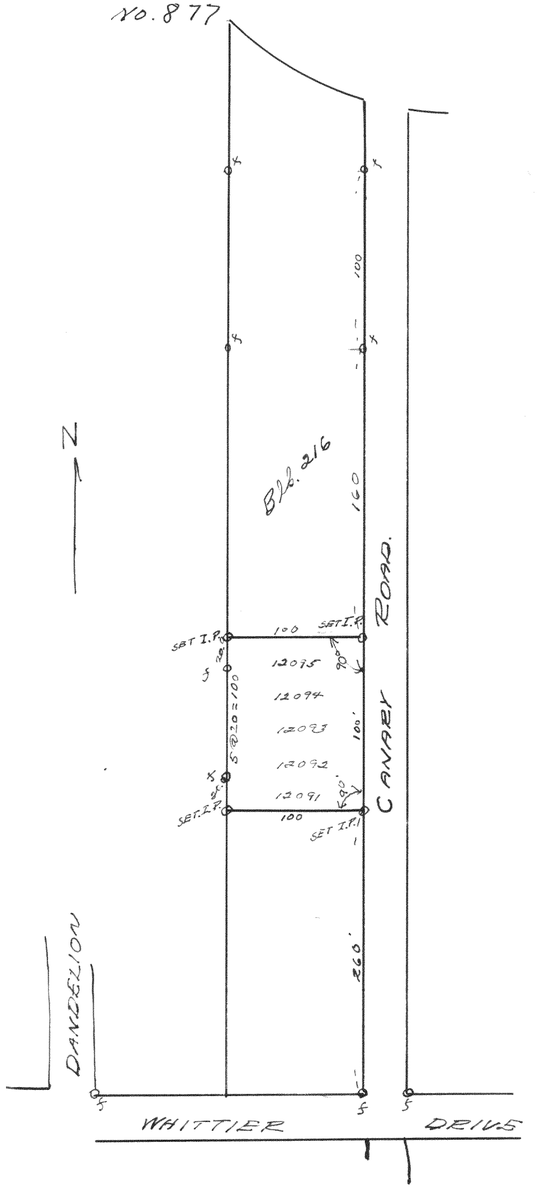

Survey of Lots 12091 to 12095 of Lake Como Beach

July 1938

Lloyd Jensen by K.E.J.