
~~287~~
285

No - 878

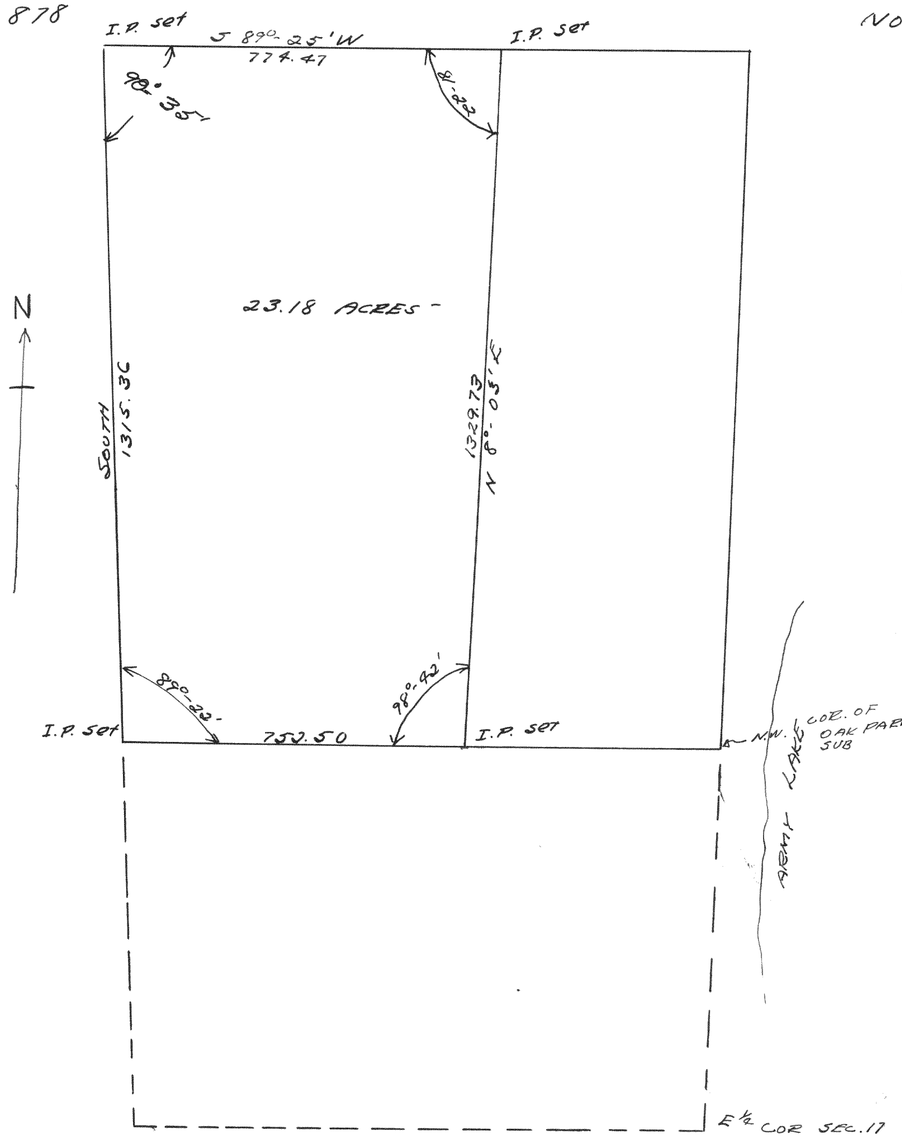


Part of sec. 17 T4N R18E.

March 31, 1938

Lloyd Jensen
by K.E.J.


No 879

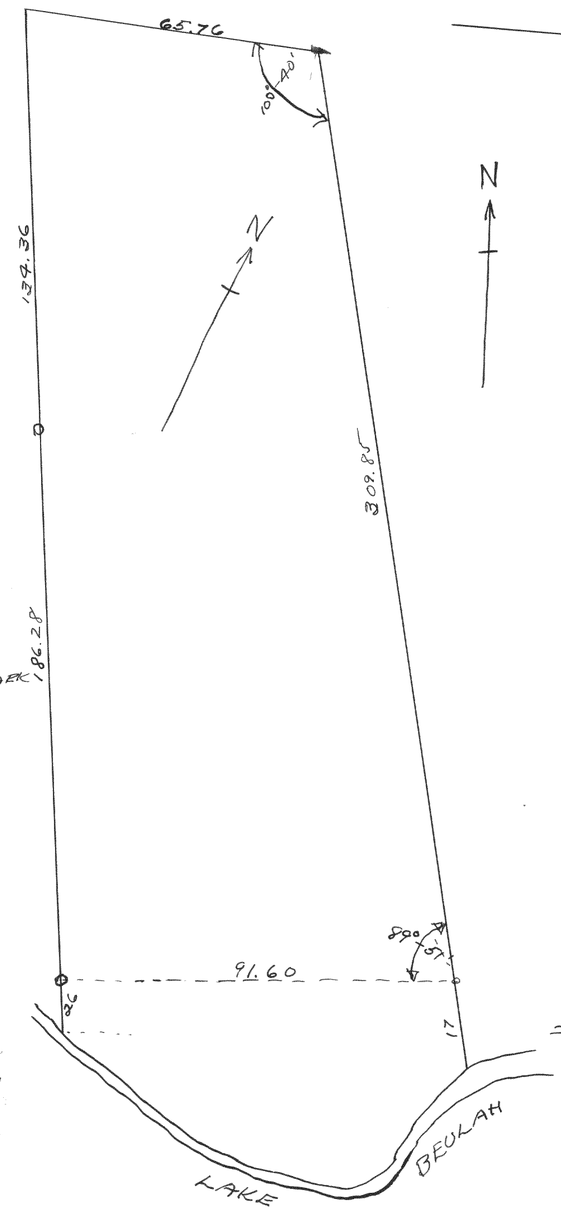

Survey of lot 8 Blk. I of Romadka Park
in sec. 5-4-18 & 8-4-18
July 14 - 1938

Lloyd Jensen
by K.E.J.

No. 880

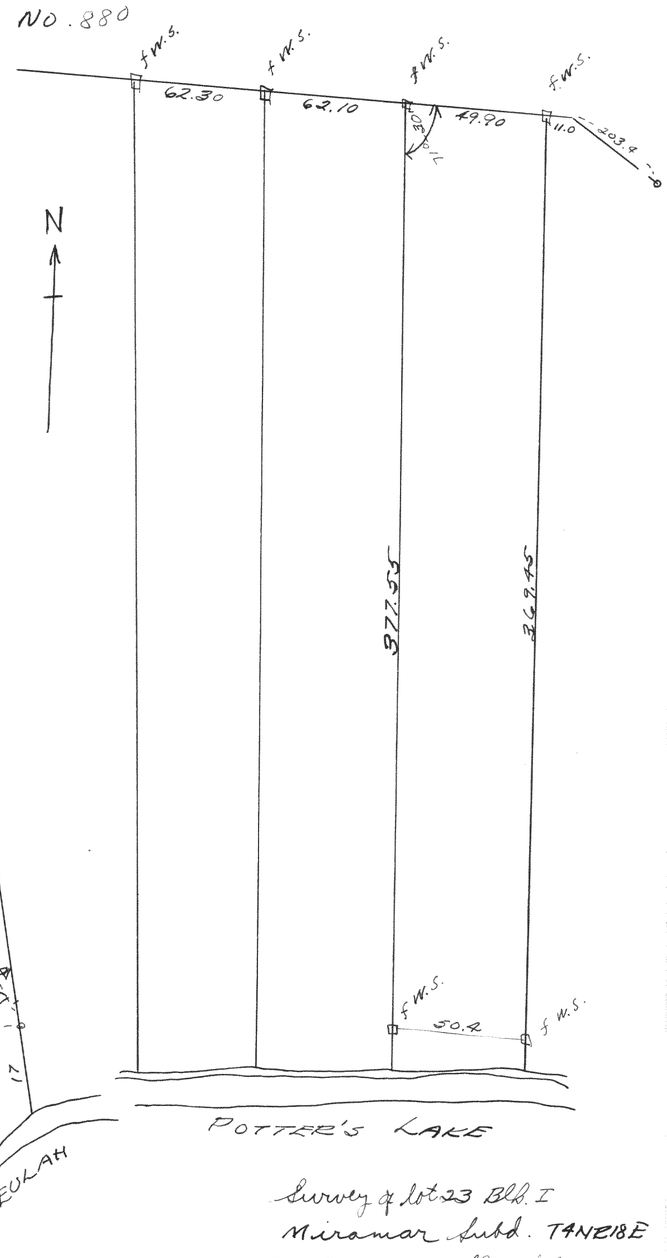

Survey of lot 23 Blk. I
Miramar Subd. T4NR18E
7-18-38

Lloyd Jensen
by K.E.J.