

No. 884

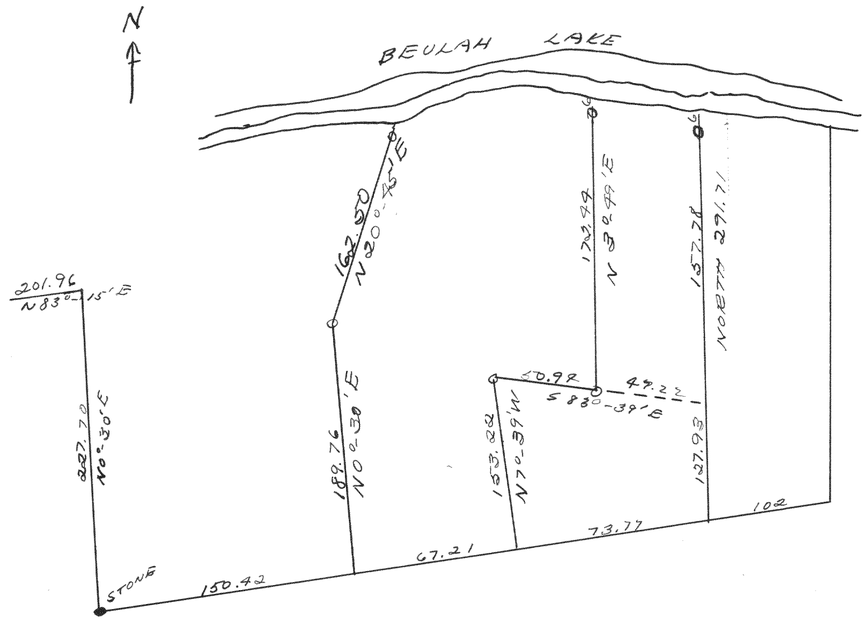

Survey of part of sec 9-7-18
Oct. 14, 1938
Lloyd Jensen
by K.E.J.

No. 885

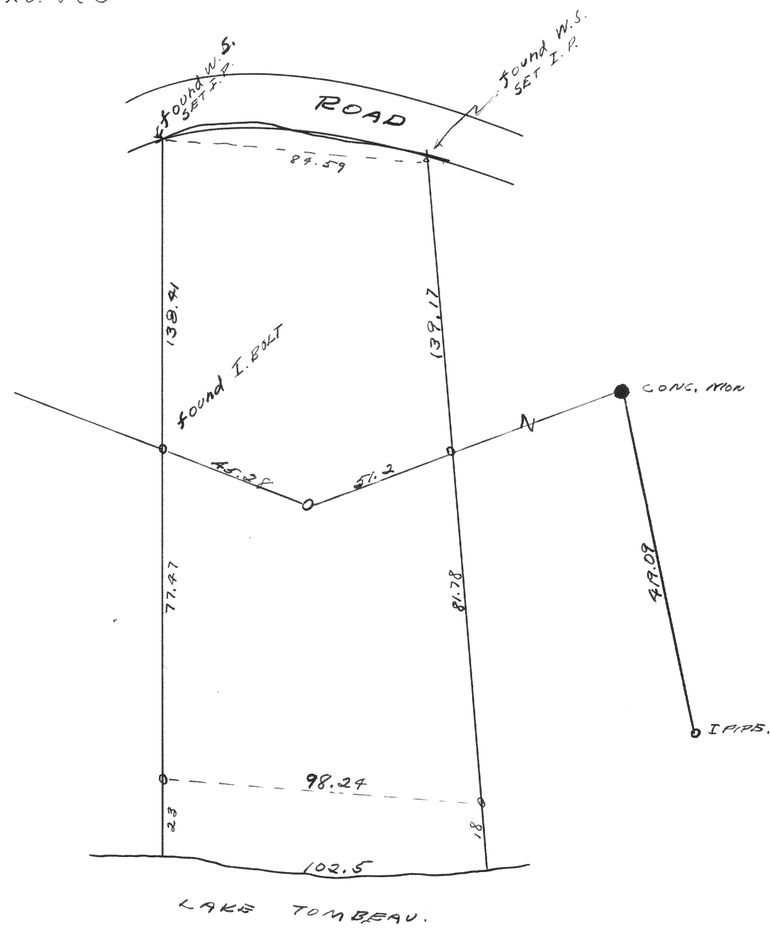

Survey of lot 2 Blk. I Nipissing Park - T1NR18E
7/6/38
Lloyd Jensen
by K.E.J.