

NO. 890

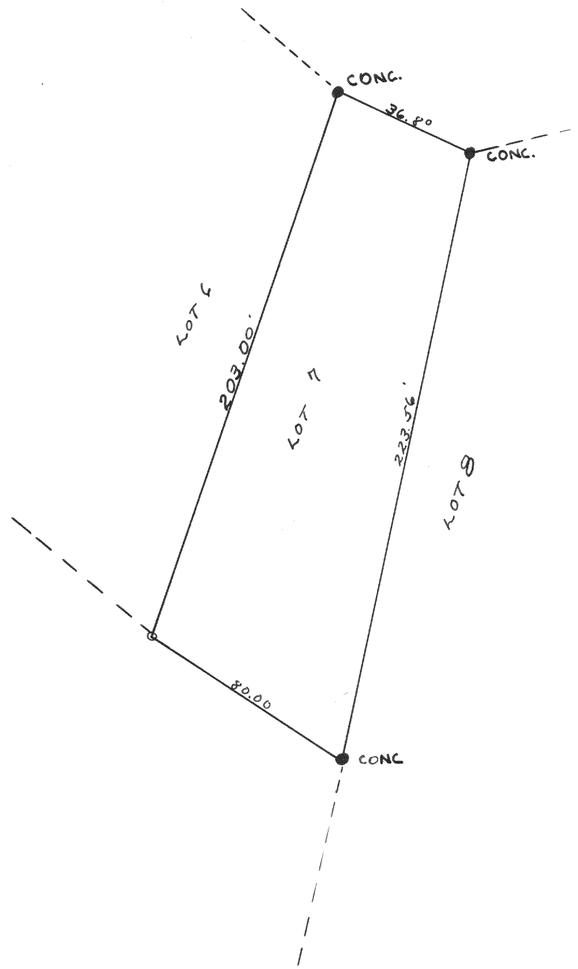

Survey of lot 7 of the 1st Add. to Cedar Pt. Park.

8-17-38 Lloyd L. Jensen of N.C.J.


NO. 891

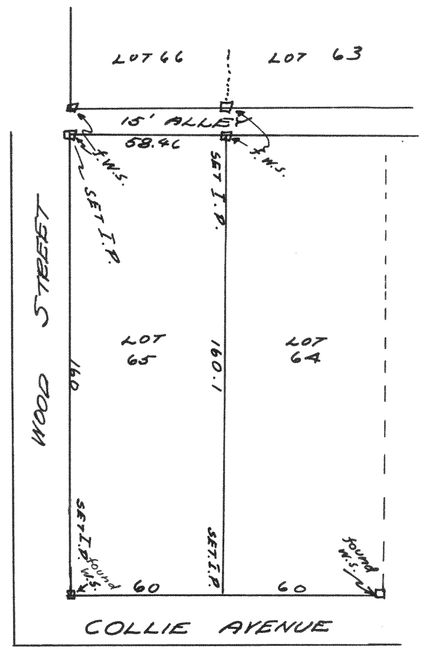

Survey of lot 65 of Bayview subdivision in the Village of Williams Bay.

Aug. 1938 Lloyd L. Jensen of N.C.J.

NO. 892 -

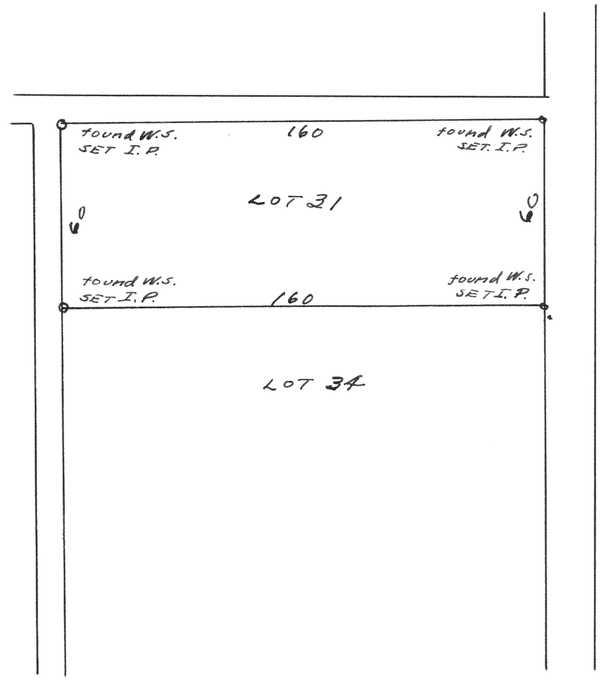

Survey of lot 31 of Bayview subdivision of the village of Williams Bay.

Mar. 23, 1938 Lloyd L. Jensen by N.C.J.