

NO. 896

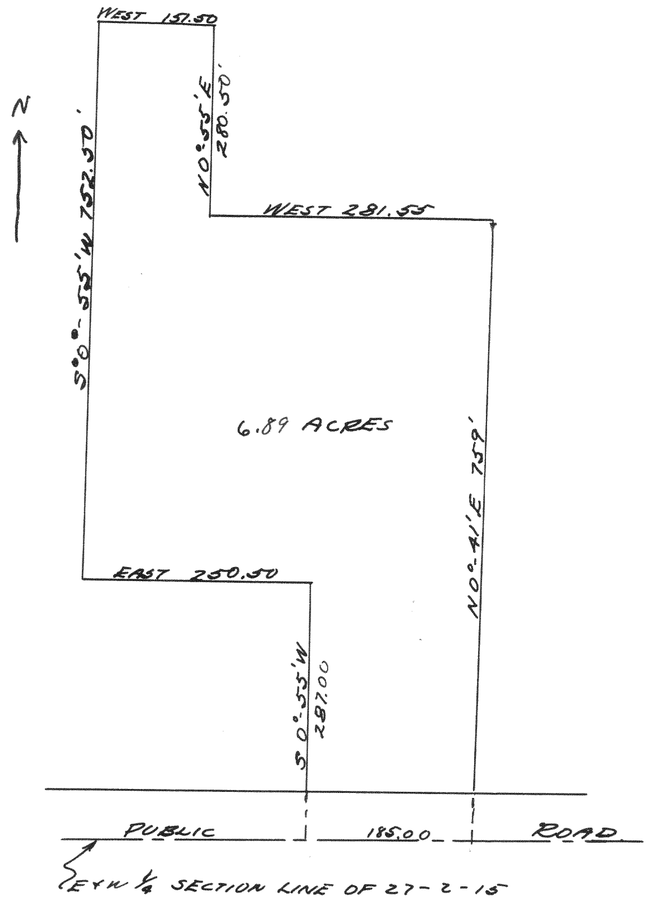

Survey of part of NW ¼ of section 27-2-15

4-21-38 Lloyd Jensen by H. E. J.


No. 897

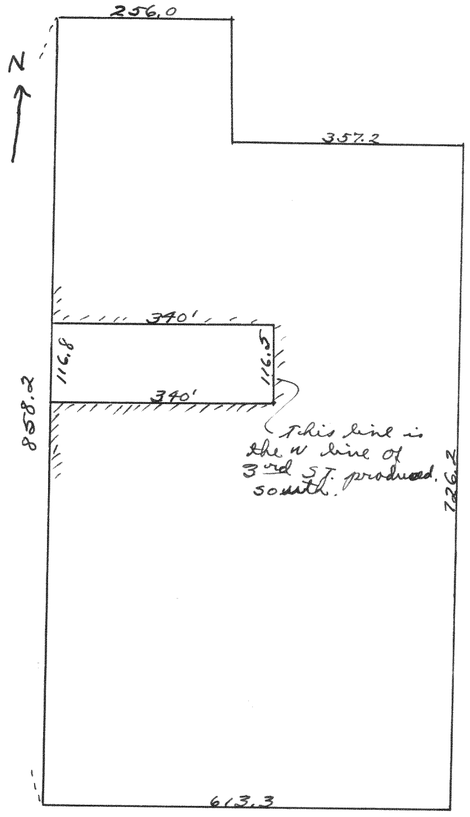

Survey of part of section 19 of the city of Delavan

July - 1937 Lloyd L. Jensen by H. E. J.

NO. 898

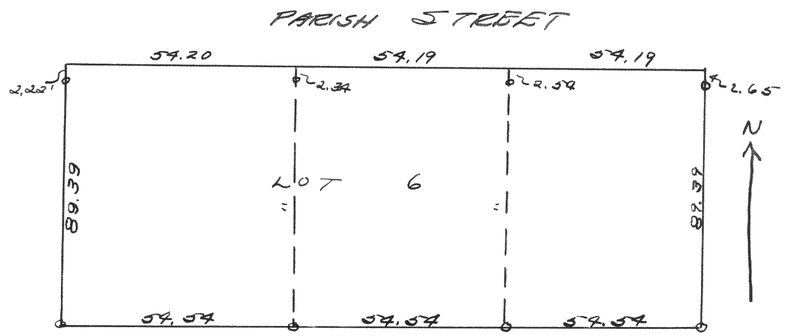

Survey of lot 6 and the south 23 feet of J. E. Dewendorf's Add. to the city of Delavan

May 1937 Lloyd L. Jensen by H. E. J.