
292

No. 899

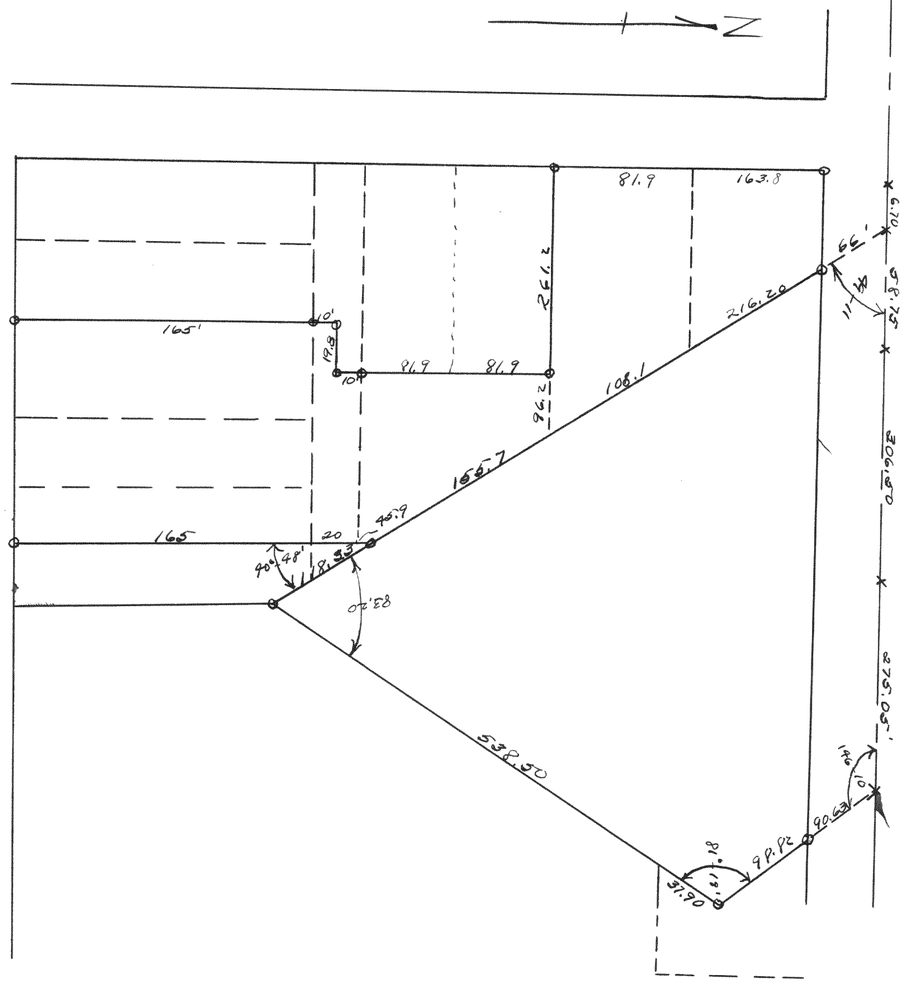


Survey of lots 1, 2, 5, 6, 7 & 8 of Blk. 5 of F.K. Phoenix West Add to the city of Delavan

July 25, 1938

Lloyd L. Jensen
by K.E.J.

No. 900

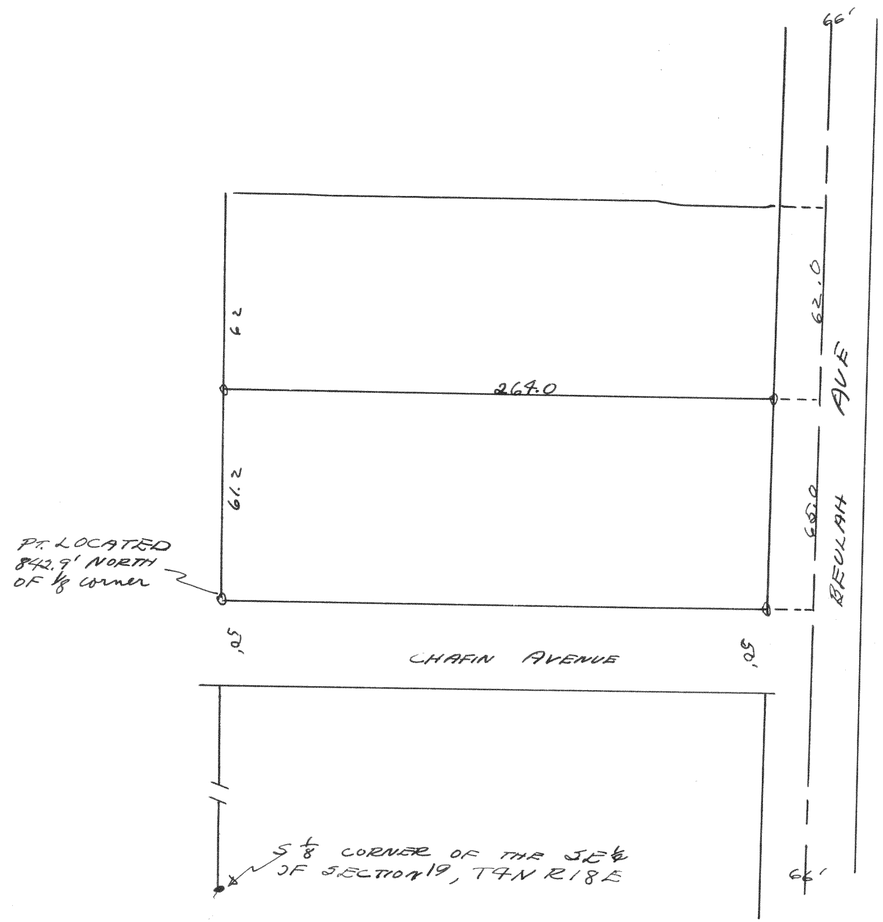

Survey of part of the SE ¼ of section 19 in the village of East Troy.

6-23-37

Lloyd L. Jensen
by K.E.J.