
2971


No. 903

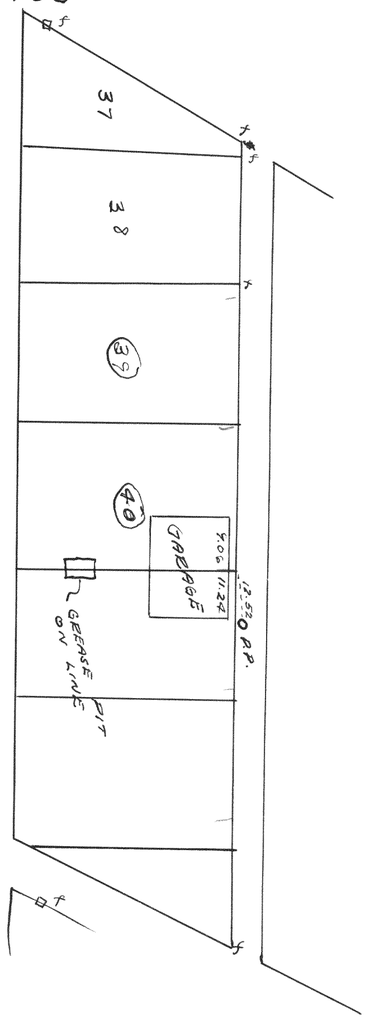

Survey of Lots 39 & 40 of Blk. 2
of 2nd Add to Inlet Oaks.
Subd. in T2N R16E

5-25-38 Lloyd L Jensen
by K.E.J.


No. 904

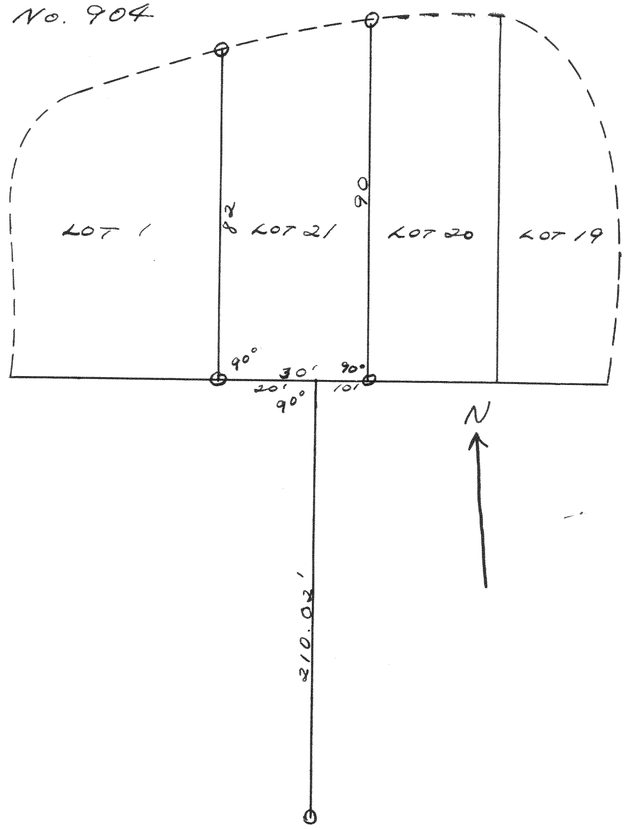

Survey of Lot 21 Blk. O
of Delavan Lake Assembly
Grounds

Nov. 21, 1938 Lloyd L. Jensen
by K.E.J.

No. 905

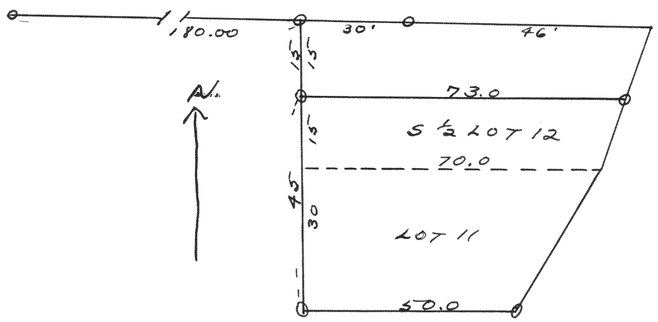

Survey of lot 11 and the South Half of lot 12 Block O of Delavan Lake Assembly Grounds

Nov. 21, 1938 Lloyd L Jensen
by K.E.J.