
NO. 906

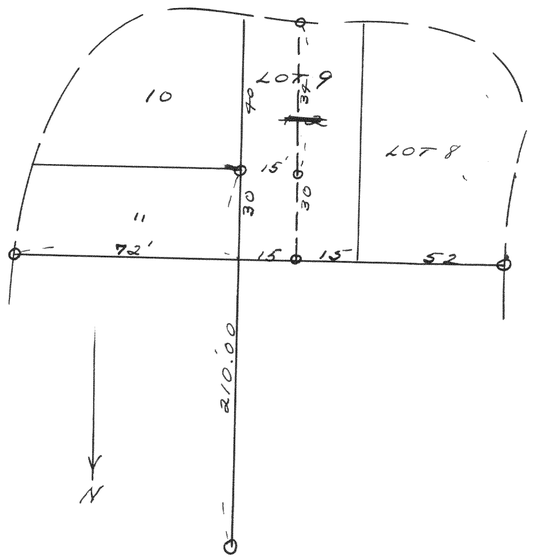


Survey of Lot 8 and West ½ of lot 9 also East ½ lot 9 and lots 10 & 11 of Delavan Lake Assembly Grounds

Nov. 21, 1938

Lloyd L Jensen
by K. E. J.

NO. 907

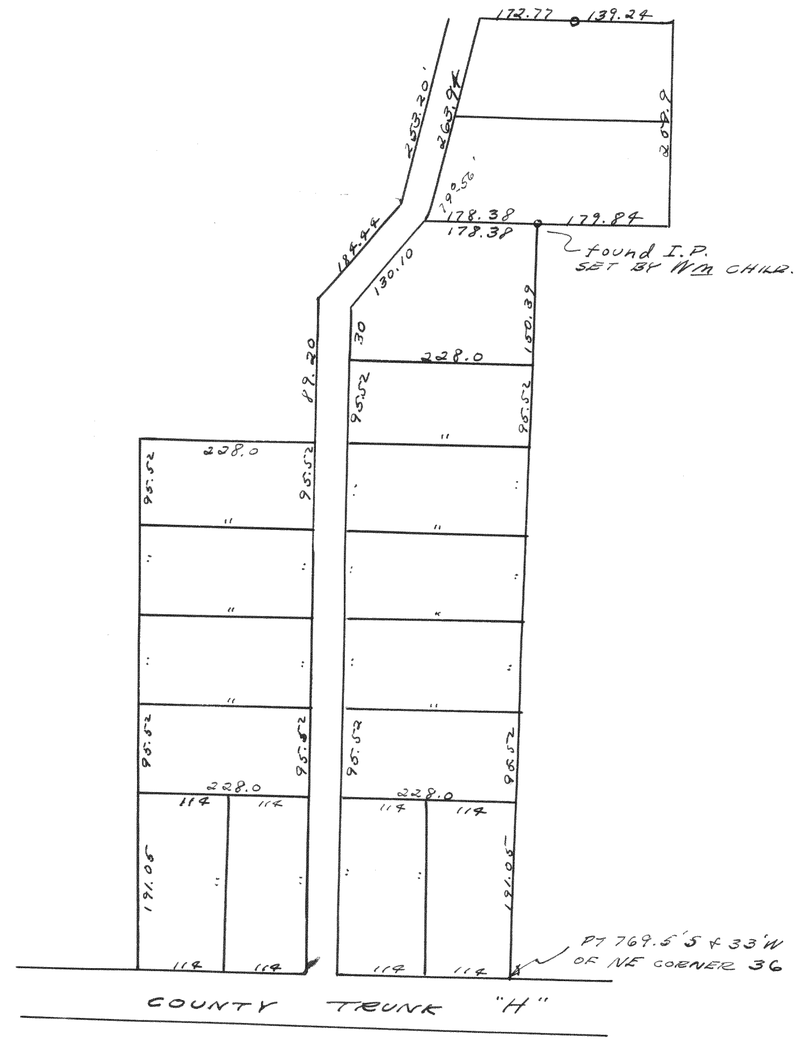

Survey of part of Sec. 36-2-16 for W. L. Lockwood.

8-20-38

Lloyd L Jensen
by K. E. J.