
2961

No. 908

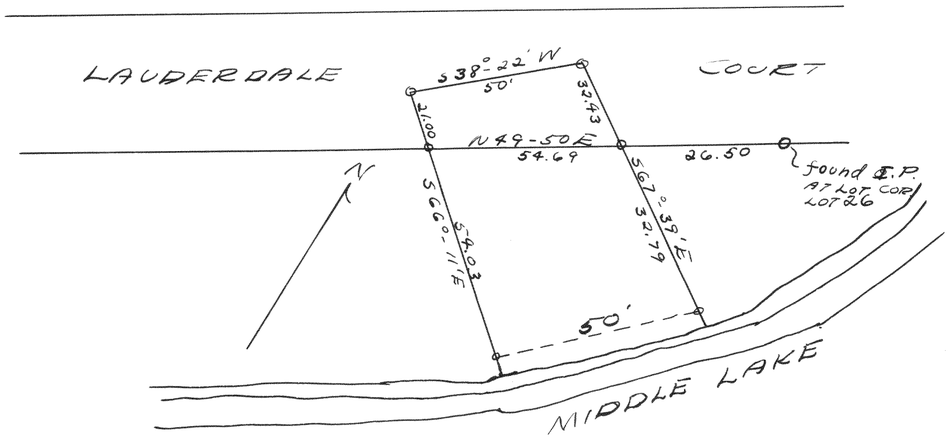


Plat of Survey of part of lot 25 of Green Island + Lauderdale Court of Green Island

9-3-37

Lloyd L. Jensen
by H.E.J.

No. 909

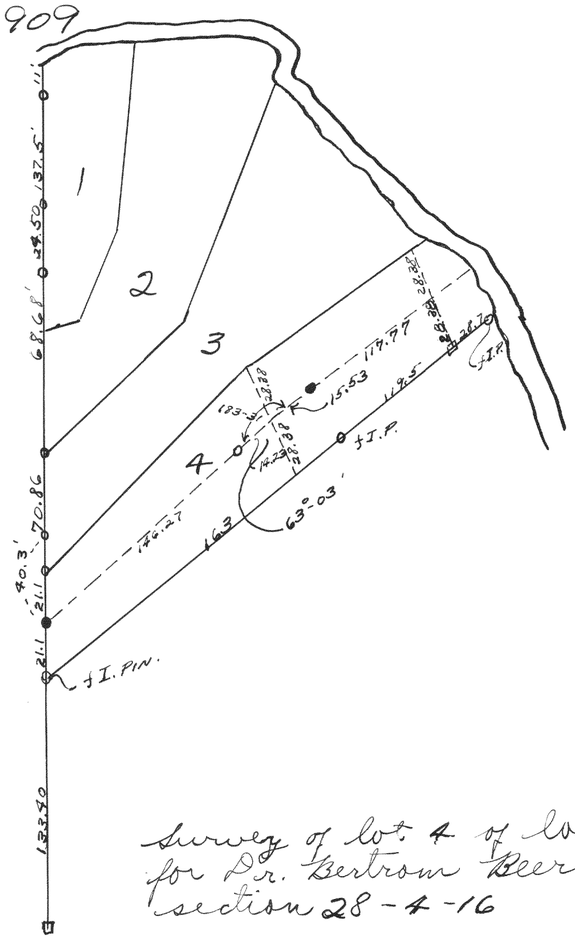

Survey of lot 4 of long point for Dr. Bertram Beers. In section 28-4-16

9-7-37

Lloyd L. Jensen
by H.E.J.