
No. 901

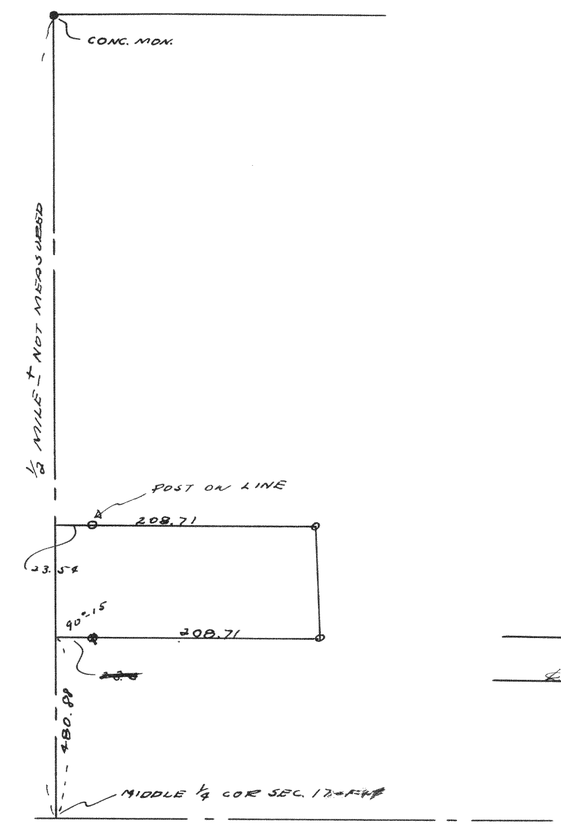


Survey of one acre of land in the SE quarter of 17-1-17

1937

Lloyd L. Jensen
by H. E. J.

No. 902

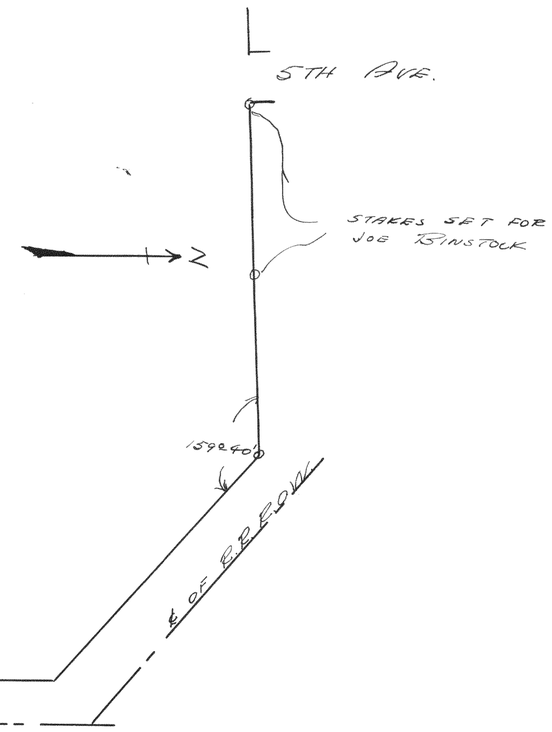


7-10-37

Survey of road fordds Village of Walworth

Lloyd L. Jensen
by H. E. J.

No. 903

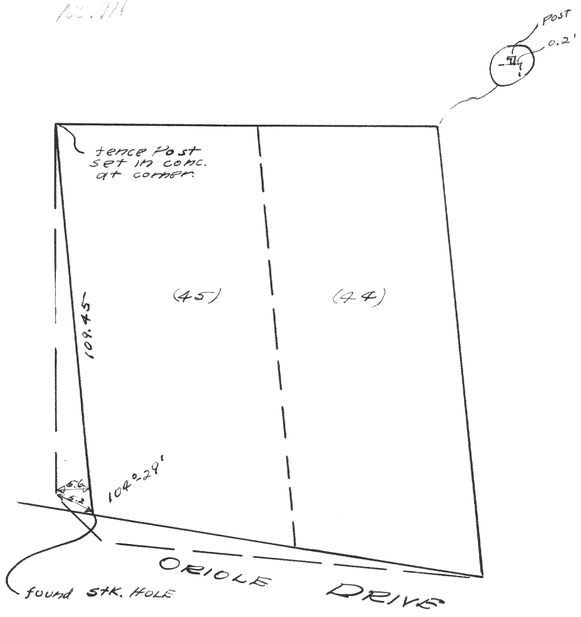

Survey of lots 44 and 45 of Frodert's Green Lake Park.

Aug., 1937

Lloyd L. Jensen
by H. E. J.