

No. 912

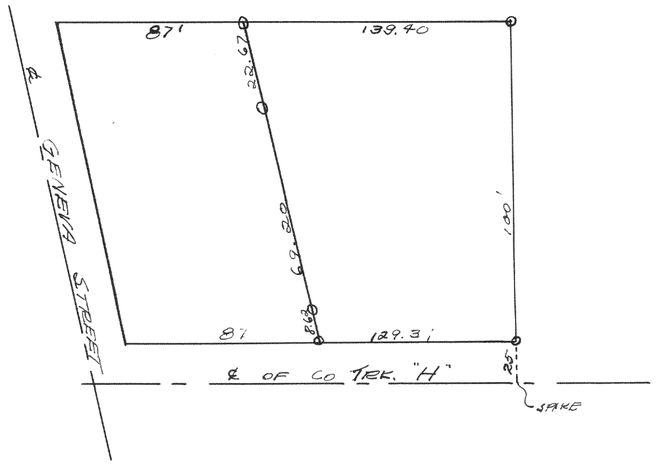


Survey of Lots 8 & 9 of Blk. I of original plat of Wms. Bay.
8-27-37 Lloyd L Jensen by W.E.J.

No. 913

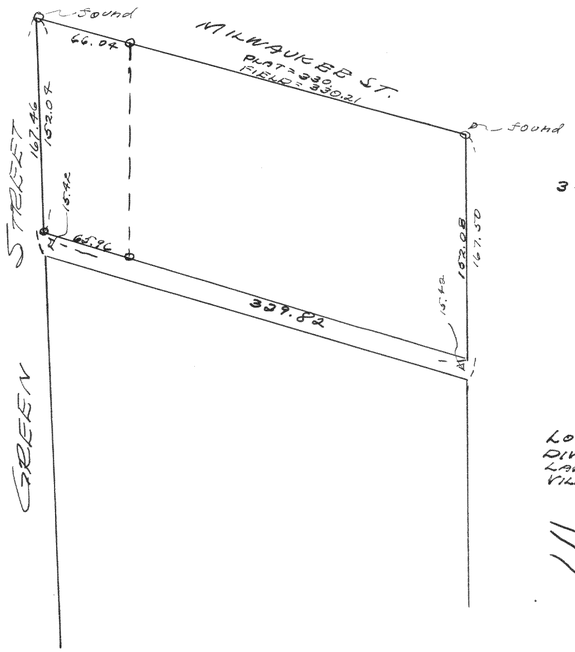

Survey of Lot 5 & Blk 2 of Briggs & Posey's Subd. of Blk. 10 in the city of Whitewater.
n.d. Lloyd L Jensen by W.E.J.

No. 914

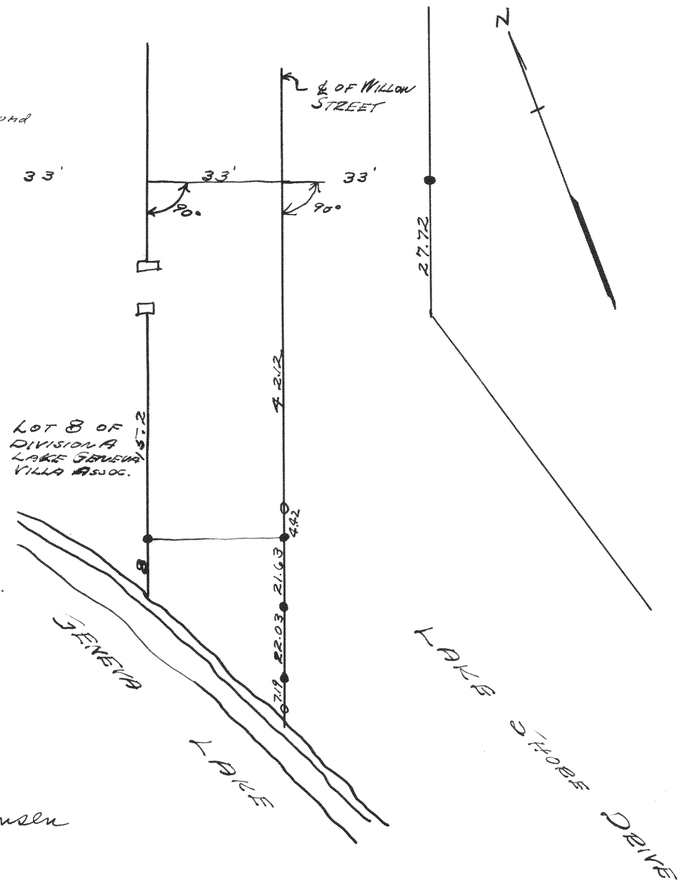

Survey of centerline of Willow Street in the city of Lake Geneva, in section 1-1-17
August 1937 Lloyd L Jensen by W.E.J.