Record of Survey.


Township 4 N, North of Range 18E of 4 Principal Meridian as presented by the courses and distances on the following plat, and annexed field-notes of survey:

Established the center of the section at the point of intersection of STRAIGHT quarter lines.

Established all quarter-quarter corners upon the section boundary at proportional distances between known section and quarter section corners, according to the original field-notes of the Government survey.

Established all lost corners at proportionate distances between known corners, according to the original field notes of the Government survey.

No. 6

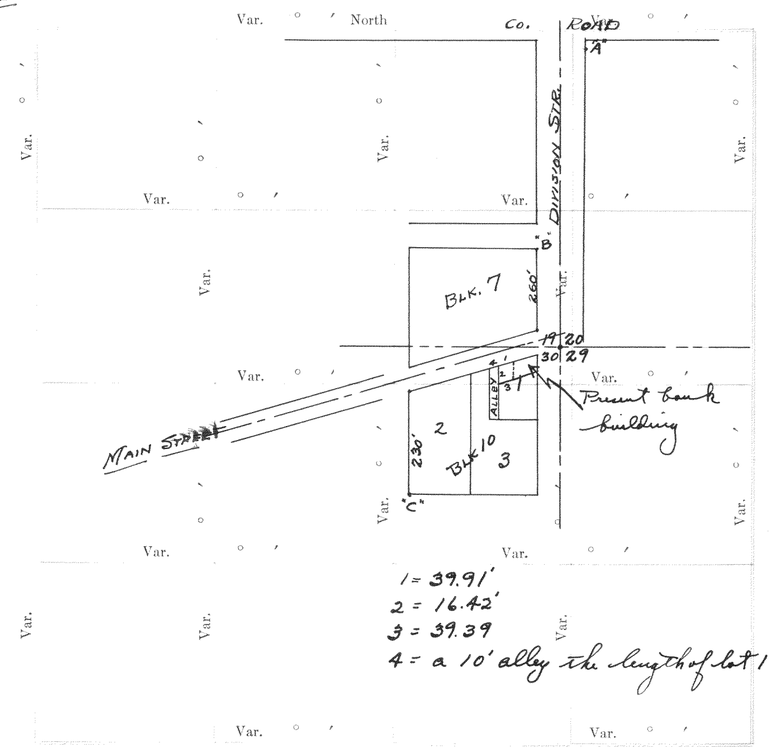

Plat of Section 30, Township 4 North, Range 18E of 4 Principal Meridian Scale 80 chains to 6 inches. The figures in red ink are the lengths of the lines as stated in the field-notes of the Government survey.

Declination of the Magnetic Meridian from the True Meridian —

Surveyed and sub-divided A. D. 1 , in accordance with the State Laws and Instructions of the Commissioner of the General Land office, and recorded on pages of Register in the County Clerk's office.

Witness my hand this day of A. D. 1

Surveyed Dec. 27, 1932 Lloyd L. Jensen SURVEYOR.
Recorded Feb 18, 1933

DESCRIPTION

OF SECTION, QUARTER SECTION AND QUARTER QUARTER SECTION CORNERS

H. C. MILLER CO. MFG. STATIONERS, MILWAUKEE X15000

GOVERNMENT CORNERS	Bearing Trees	In. Dia.	Courses they bear	Links Distant	Bearing Trees	In. Dia.	Courses they bear	Links Distant	Bearing Trees	In. Dia.	Courses they bear	Links Distant	Bearing Trees	In. Dia.	Courses they bear	Links Distant
No.																
1. N. W. Sec. Cor. indentified,																
2. N. E. Sec. Cor. indentified,																
3. S. E. Sec. Cor. indentified,																
4. S. W. Sec. Cor. indentified,																
5. N. ¼ Sec. Cor. indentified,																
6. E. ¼ Sec. Cor. indentified,																
7. S. ¼ Sec. Cor. indentified,																
8. W. ¼ Sec. Cor. indentified,																

Subdivision Corners

No.																
1. Center ¼ Sec. Cor.																
2. North ¼-¼s N. W. qr.,																
3. East ¼-¼s N. W. qr.,																
4. South ¼-¼s N. W. qr.,																
5. West ¼-¼s N. W. qr.,																
6. Center ¼-¼s N. W. qr.,																
7. North ¼-¼s N. E. qr.,																
8. East ¼-¼s N. E. qr.,																
9. South ¼-¼s N. E. qr.,																
10. Center ¼-¼s N. E. qr.,																
11. East ¼-¼s S. E. qr.,																
12. South ¼-¼s S. E. qr.,																
13. West ¼-¼s S. E. qr.,																
14. Center ¼-¼s S. E. qr.,																
15. South ¼-¼s S. W. qr.,																
16. West ¼-¼s S. W. qr.,																
17. Center ¼-¼s S. W. qr.																


NAMES OF SWORN ASSISTANTS

CHAINMEN	FLAGMEN	AXMEN

No 6

Survey – to locate boundary lines for East Troy State Bank
Location – Lot 1, Blk. 10 original town of East Troy
Sec. 30, T4N, R18E
Monuments – found street line at A from which we measured 33' west and obtained the sec. line and ℄ of Division Street.
"B" is the corner of the old Wilmer Bros. store which is the NE. Cor. of Blk 7.
"C" the old original stake hole was found which marks the SW. cor. of Blk 10.
Procedure – Located the center lines of Division Str. & of Main Str. as shown. Located the alley line along the West side of Lot 1, Blk. 10. Then located the intersection of the south line of main street and the East line of the alley and determined the size & location of the bank lot.

No. 7

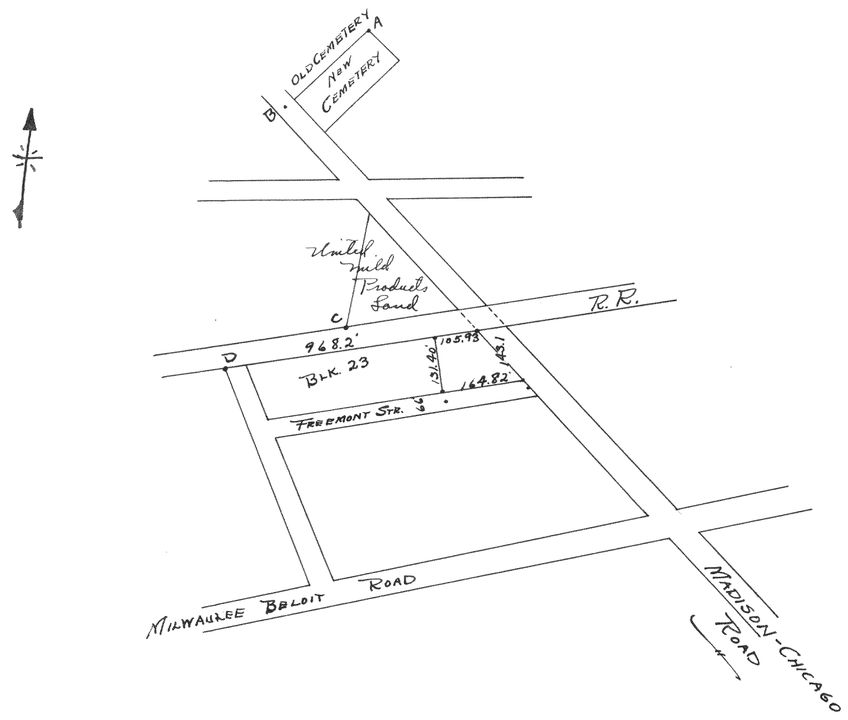

Survey – of lots in Village of Darien
Location – Lots 142, Blk 23, John Bruce's Addn. to Darien
Monuments – Found an iron pipe at "A" marking east boundary of cemetery, measured West & located ℄ of old road at "B"
Found iron pin at "C" – measured 617 feet east & located ℄ of same road.
Found original stone at "D" marking street & Blk Cor.
Procedure – measured Blk. 23 to determine its true length and found it differed from plat. Divided up error in proportion to size of lots and laid out the lots accordingly.
Survey made by Wal. C. Highway Dept.

Recorded by Lloyd. T. Jensen
County Surveyor.