Record of Survey.


No. 77

Township....., North of Range.....of 4 Principal Meridian as presented by the courses and distances on the following plat, and annexed field-notes of survey:

Established the center of the section at the point of intersection of STRAIGHT quarter lines.

Established all quarter-quarter corners upon the section boundary at proportional distances between known section and quarter section corners, according to the original field-notes of the Government survey.

Established all lost corners at proportionate distances between known corners, according to the original field notes of the Government survey.

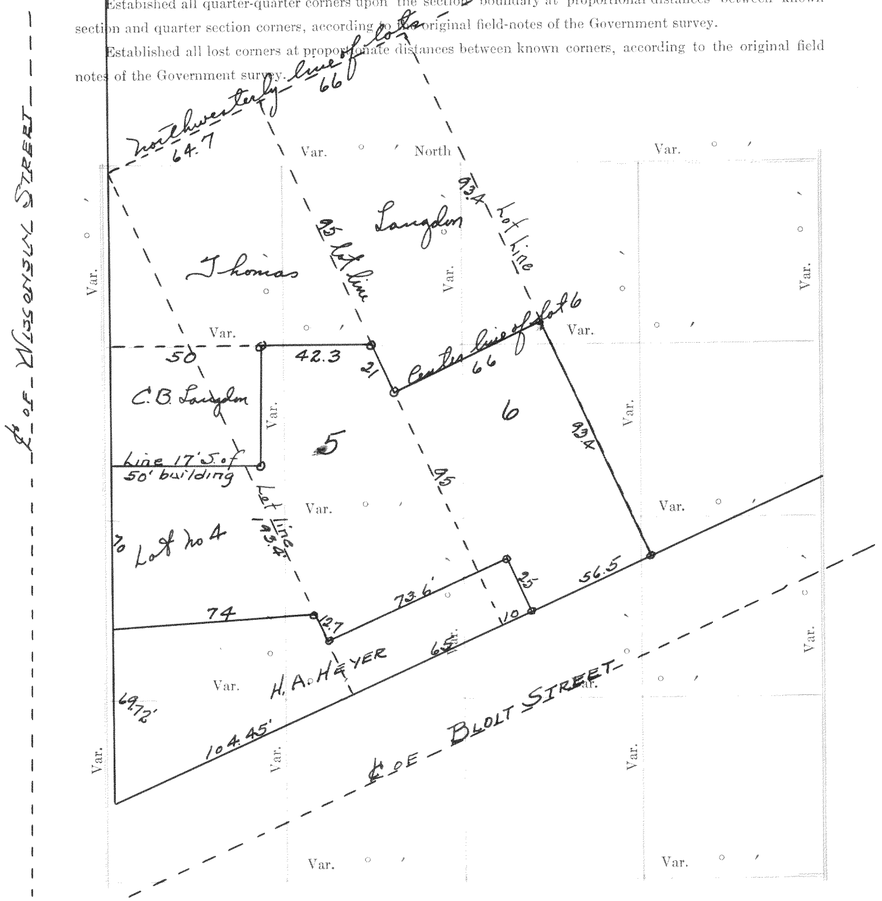

Plat of Section....., Township.....North, Range.....of 4 Principal Meridian Scale 80 chains to 6 inches. The figures in red ink are the lengths of the lines as stated in the field-notes of the Government survey.

Declination of the Magnetic Meridian from the True Meridian.....

Surveyed and sub-divided.....A. D. 1 , in accordance with the State Laws and Instructions of the Commissioner of the General Land office, and recorded on pages .....of Register in the County Clerk's office.

Witness my hand this.....day of.....A. D. 1

.....SURVEYOR.

DESCRIPTION

OF SECTION, QUARTER SECTION AND QUARTER QUARTER SECTION CORNERS

N. C. MILLER CO., MFG. STATIONERS, MILWAUKEE X15000

GOVERNMENT CORNERS	Bearing Trees	In. Dia.	Courses they bear	Links Distant	Bearing Trees	In. Dia.	Courses they bear	Links Distant	Bearing Trees	In. Dia.	Courses they bear	Links Distant	Bearing Trees	In. Dia.	Courses they bear	Links Distant
No.																
1. N. W. Sec. Cor. indentified,																
2. N. E. Sec. Cor. indentified,																
3. S. E. Sec. Cor. indentified,																
4. S. W. Sec. Cor. indentified,																
5. N. ¼ Sec. Cor. indentified,																
6. E. ¼ Sec. Cor. indentified,																
7. S. ¼ Sec. Cor. indentified,																
8. W. ¼ Sec. Cor. indentified,																
Subdivision Corners																
No.																
1. Center ¼ Sec. Cor.																
2. North ¼-¼s N. W. qr.,																
3. East ¼-¼s N. W. qr.,																
4. South ¼-¼s N. W. qr.,																
5. West ¼-¼s N. W. qr.,																
6. Center ¼-¼s N. W. qr.,																
7. North ¼-¼s N. E. qr.,																
8. East ¼-¼s N. E. qr.,																
9. South ¼-¼s N. E. qr.,																
10. Center ¼-¼s N. E. qr.,																
11. East ¼-¼s S. E. qr.,																
12. South ¼-¼s S. E. qr.,																
13. West ¼-¼s S. E. qr.,																
14. Center ¼-¼s S. E. qr.,																
15. South ¼-¼s S. W. qr.,																
16. West ¼-¼s S. W. qr.,																
17. Center ¼-¼s S. W. qr.																

Plat of a survey made by the direction of the heirs of J. A. Hunsbucker of Darien, ~~Wisconsin~~ Walworth County, Wisconsin, to locate the boundary of a lot of the said Hunsbucker Estate, located in lots 4 & 6 of Block 8 of the Plat of the Village of Darien, which plat is on record in the office of the Register of Deeds in and for the said County in Volume No. 2 of Plats on page 12.

Iron stakes were driven at the corners marked o


Elkhorn Wis 8th 1928
Th. Child
County Surveyor.

Recorded by Floyd S. Jensen C.S.
Jan 11, 1934

NAMES OF SWORN ASSISTANTS

CHAINMEN	FLAGMEN	AXMEN

No. 78

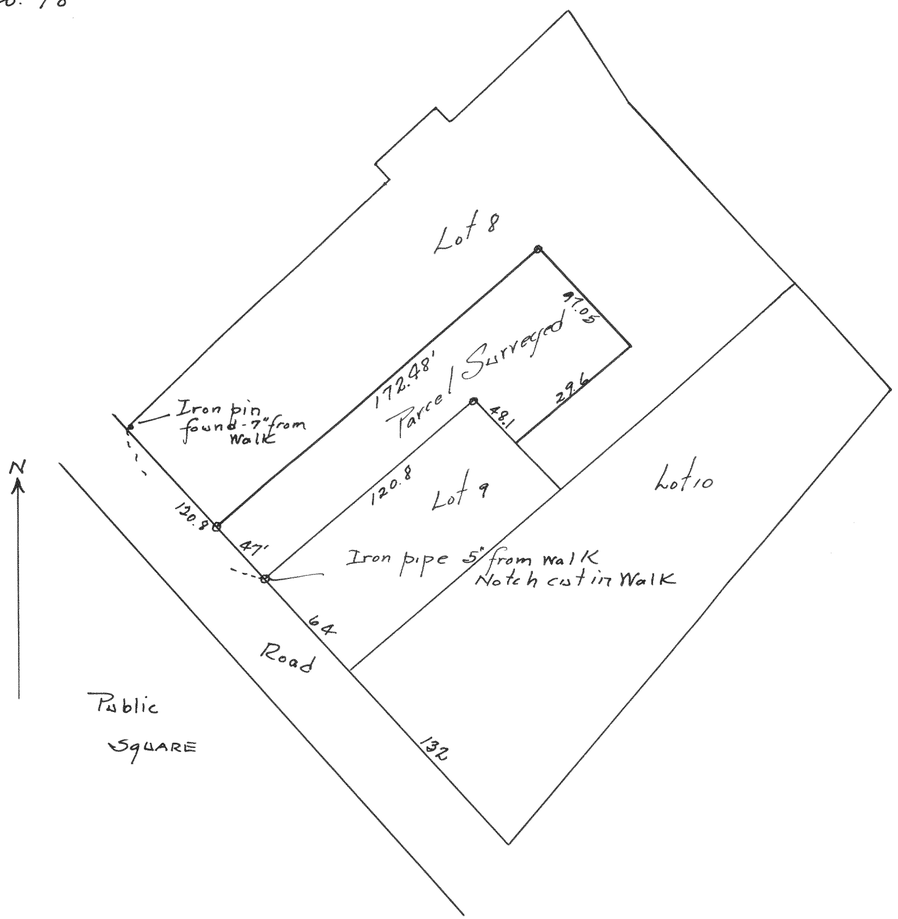

Survey for Hunsbuckers of Harlem –

Description of parcel surveyed –

Beginning 74.37 feet South ~~westerly~~ easterly of the north west corner of Lot 8, Block 26 of the 4th Addition to Harlem, in Section 27, T27N, R15E, thence Northeasterly 172.48' to an iron pipe in the fence line; thence Southeasterly along the fence 97.05 feet to the corner fence post; thence Southwesterly 29.6 feet to the East side of lot 9; thence Northwesterly along the Easterly boundary of lot 9, 48.1 feet to the Northerly corner of lot 9, thence Southwesterly 120.8 feet along the Northerly side of lot 9 to the public road; thence Northwesterly 47' to the place of beginning.

Lloyd S. Jensen
County Surveyor
Aug 11, 1933