

No 9 Survey No. 919

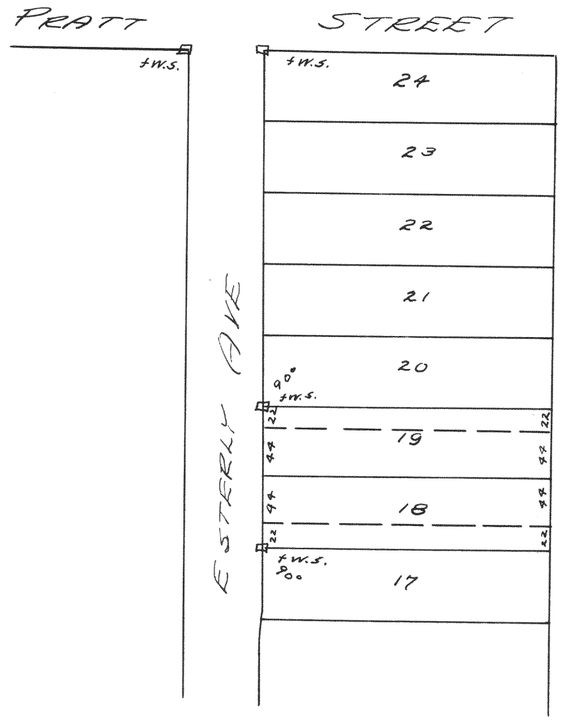


Survey of the N 44' of lot 18 and the S 44' of lot 19, Blk. 1 Pugh & Johnson's Add to the City of Whitewater.

Survey No. 920

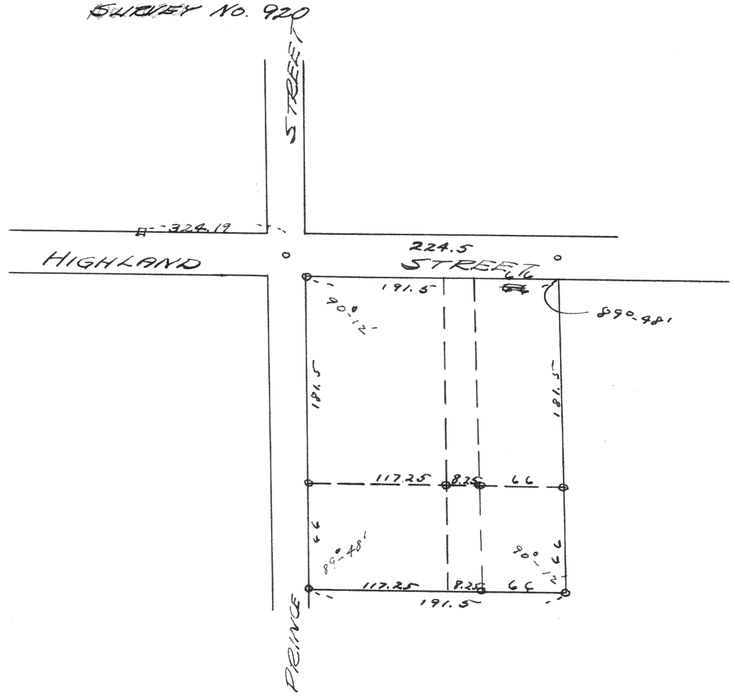

Survey of part of Block 5 of Birges Add. to the City of Whitewater.

Survey No. 924

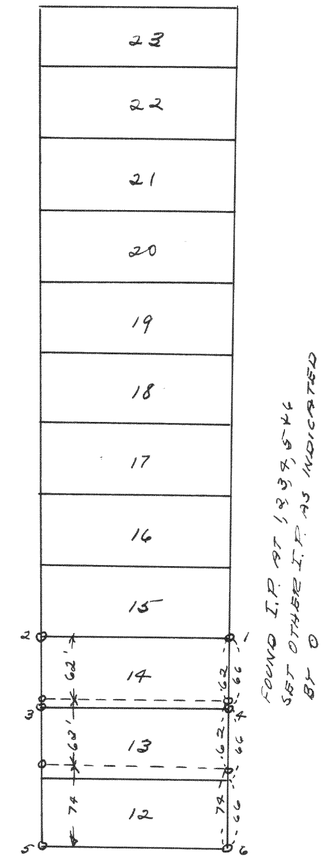

Survey of Lots 12, 13 & 14 of Cooper & Coles Add to the City of Whitewater.

(10-4-38) Lloyd L. Jensen
by W.E.J.